


NOTE: SET 1/2" Ø IRON RODS ON CORNERS OF LOT 7 & LOTS 10-11-12.  
ALL OTHER MARKERS FOUND FROM PREVIOUS SURVEY.

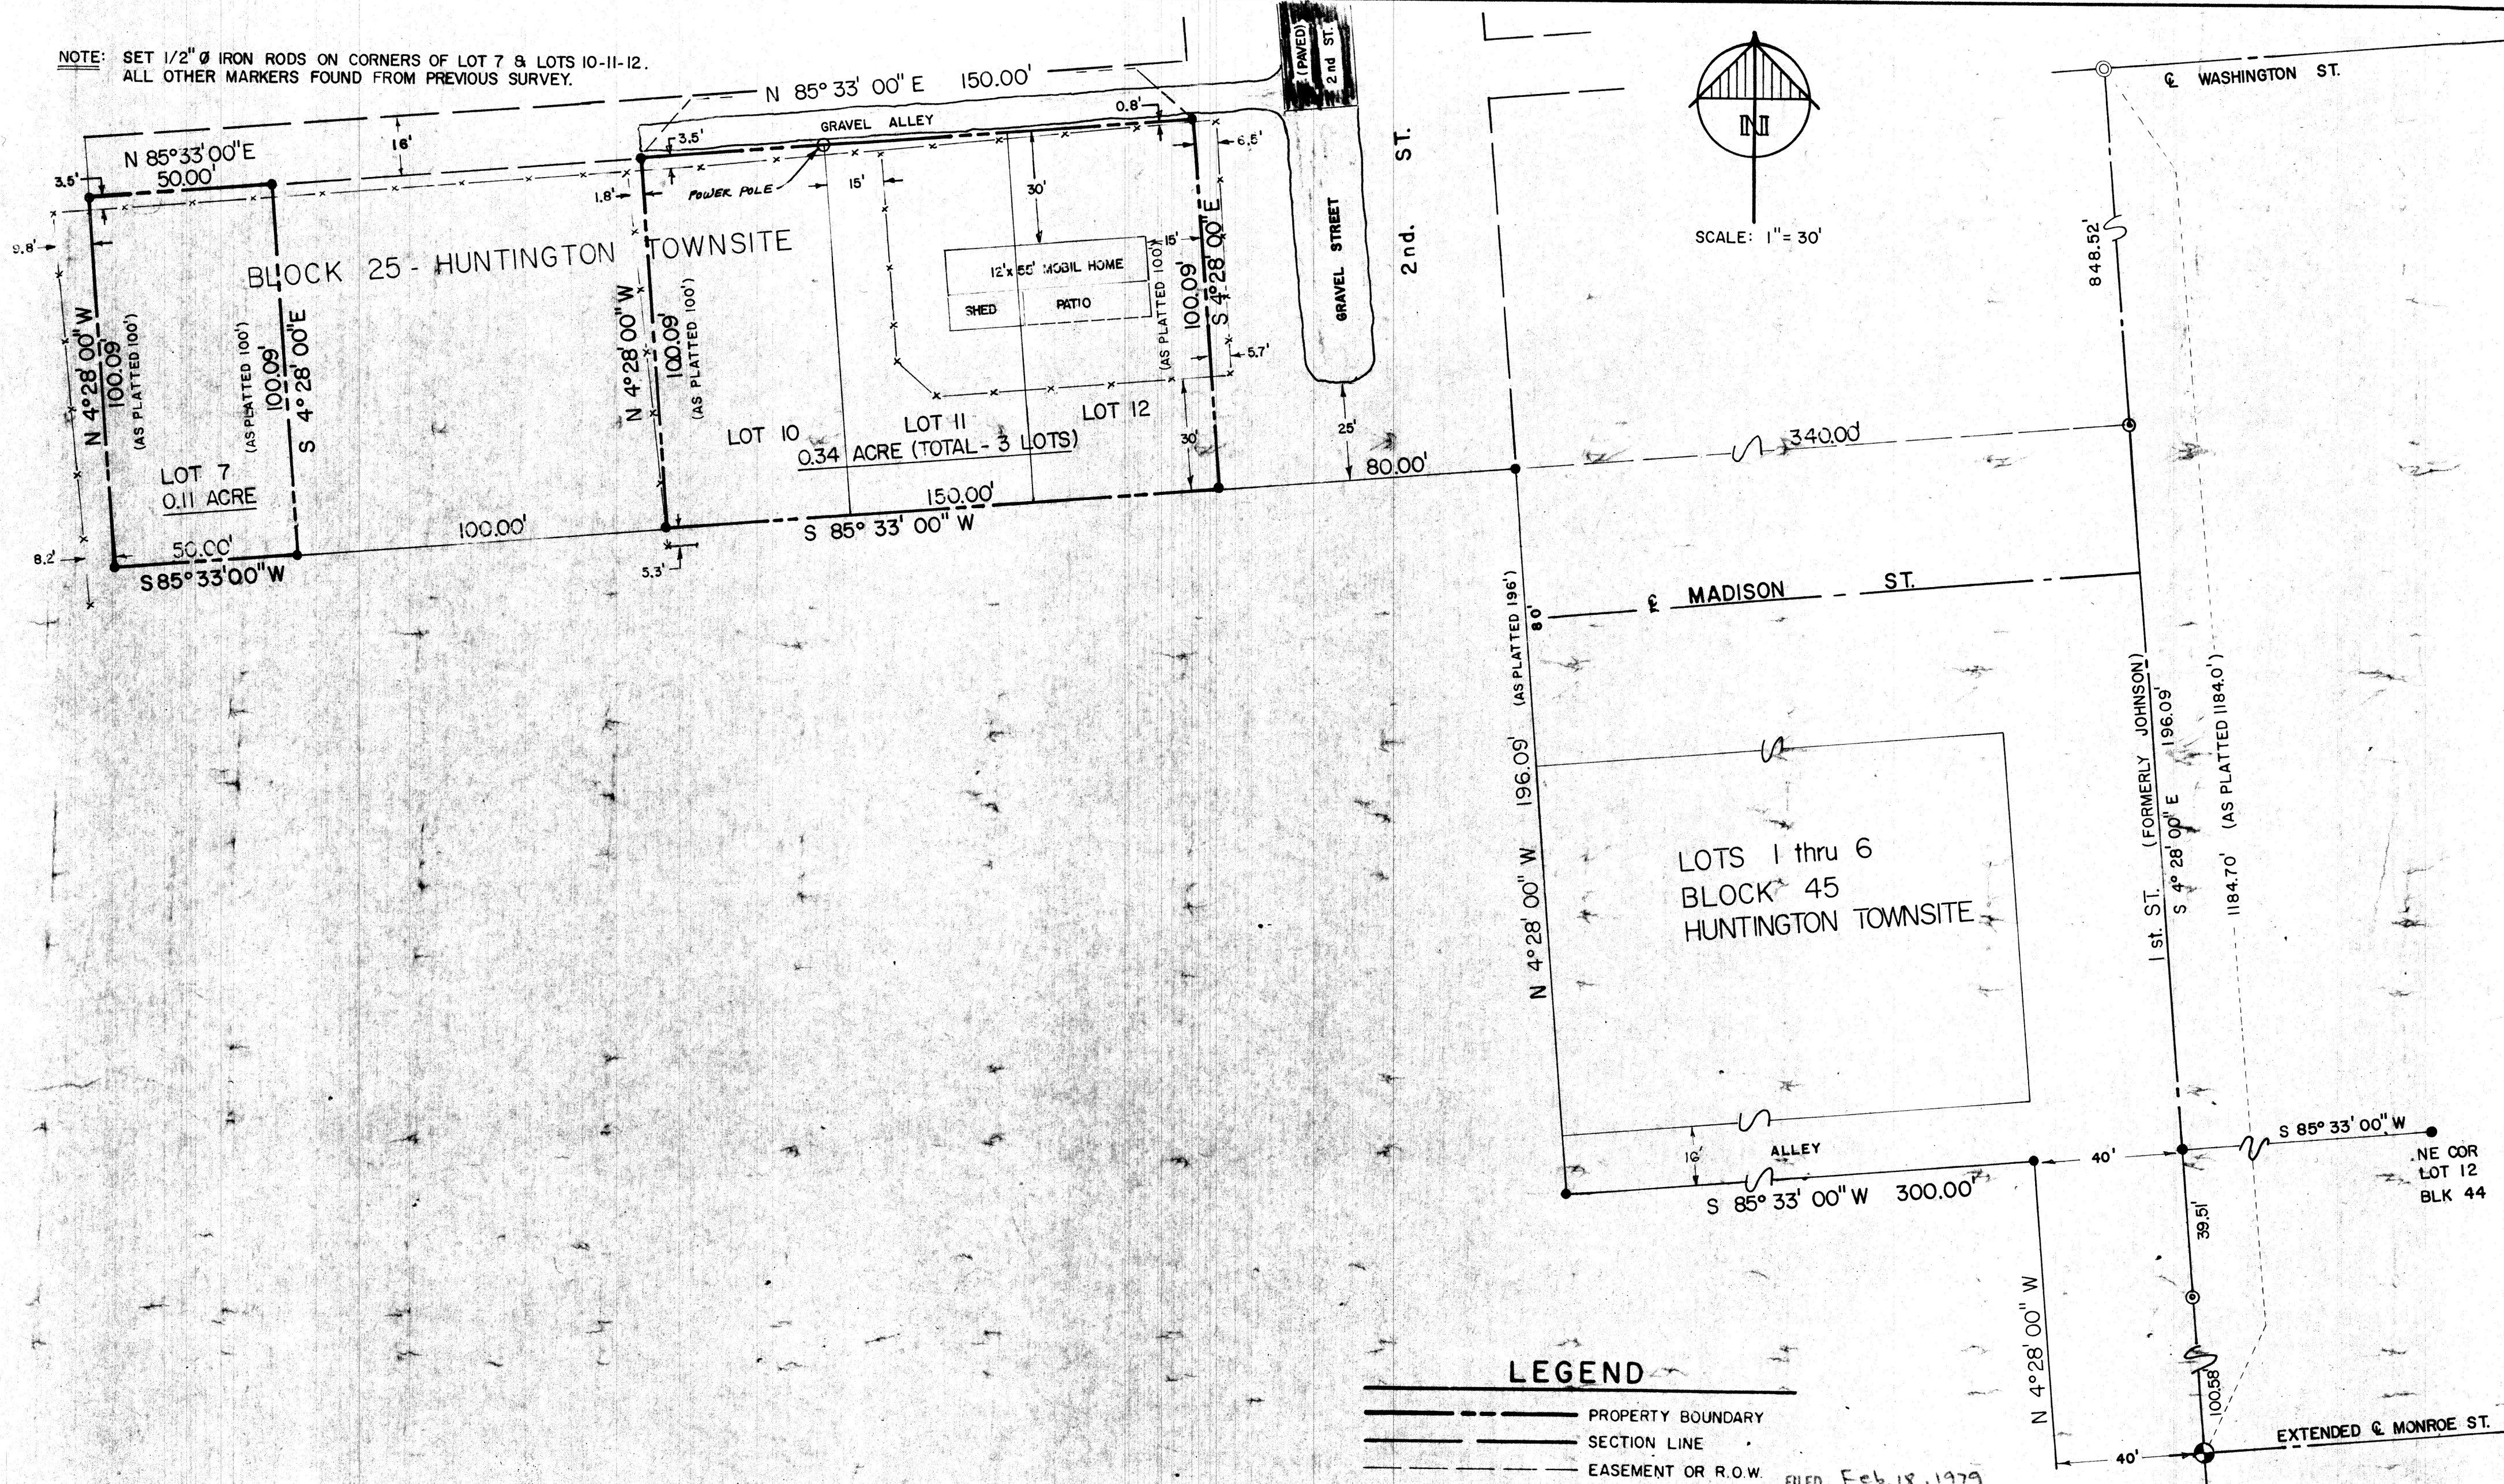

## LEGEND

- |                                                                                       |                         |
|---------------------------------------------------------------------------------------|-------------------------|
|  | PROPERTY BOUNDARY       |
|  | SECTION LINE            |
|  | EASEMENT OR R.O.W.      |
|  | CENTERLINE              |
|  | FENCE                   |
|  | DITCH OR CANAL          |
|  | BRASS CAP               |
|  | 5/8" Ø IRON ROD         |
|  | 1/2" Ø IRON ROD         |
|  | P.K. NAIL               |
| POB                                                                                   | POINT OF BEGINNING      |
| TPB                                                                                   | TRUE POINT OF BEGINNING |

FILED Feb. 18, 1979  
BAKER COUNTY SURVEYOR  
SURVEY NO. 14-44-11

## RECORD OF SURVEY

SEC. 13 T. 14 S., R. 44 E., W. M.

**SURVEY FOR -**

DARLENE GRAVES

ALL OF LOTS 7, 10, 11, 12 OF BLOCK 25 HUNTINGTON TOWNSITE

BLAKLEY ENGINEERS, INC.

CHARTERED


Caldwell Payette Emmett Ontario

DATE • 20 DECEMBER, 1979

DRAWN • D.W.  
CHECKED •

JOB NO • SQ 121479

BOOK • S-50

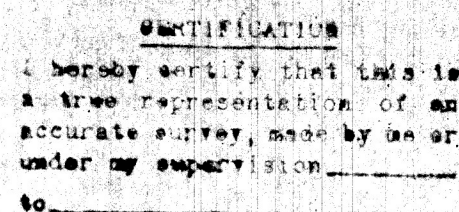

ORE. L. S. # 1125

14-44-11 G-69