14-44-21

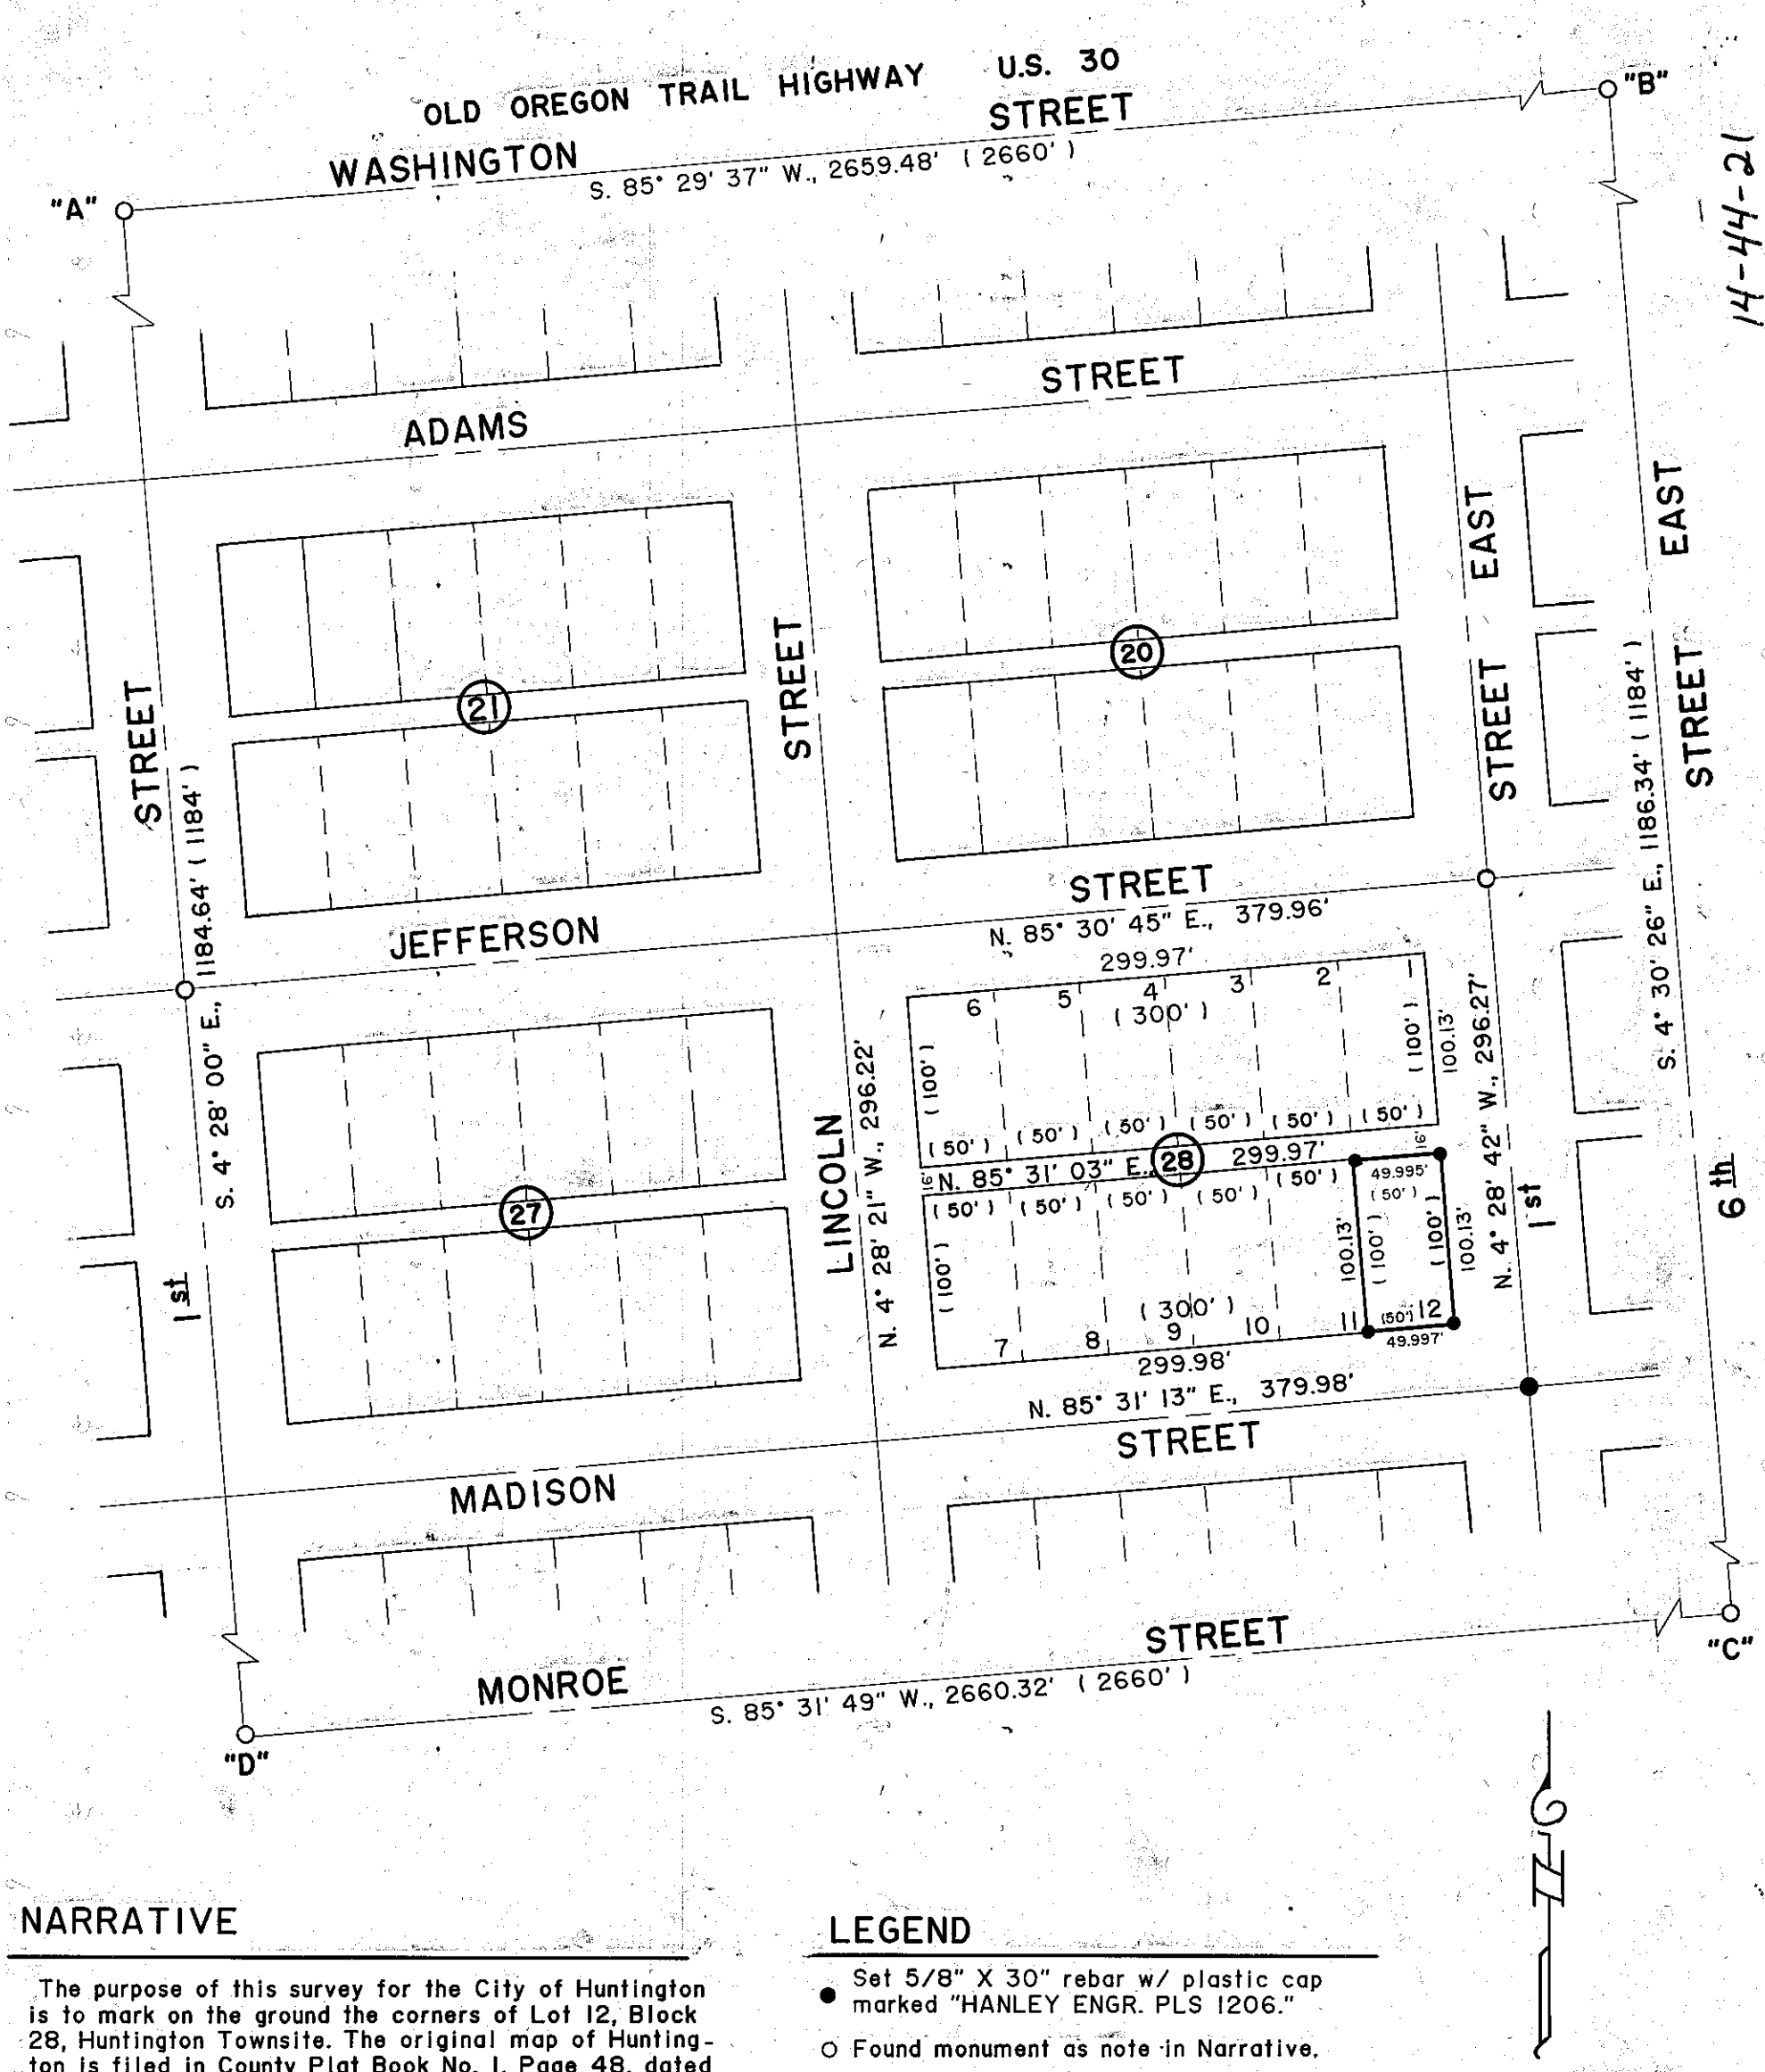

NARRATIVE

The purpose of this survey for the City of Huntington is to mark on the ground the corners of Lot 12, Block 28, Huntington Townsite. The original map of Huntington is filed in County Plat Book No. 1, Page 48, dated April 8, 1886. The plat describes "four permanent corners having been established at points "A", "B", "C" and "D". All monumentation marking these points was recovered; consisting of the following: "A" monument at 1st and Washington is now a 5/8 inch rebar; "B" monument at 6th and Washington is the original 2 1/2 inch X 4 inch steel plate; "C" monument at 6th and Monroe is now a 1 inch diam. iron rod; "D" monument at 1st and Monroe is now a 2 1/2 inch diam. brass cap in concrete. Further explanation is found in Survey 14-44-14. The record bearing between "A" and "D" of N. 04° 28' E. is held for this survey.

LEGEND

● Set 5/8" X 30" rebar w/ plastic cap marked "HANLEY ENGR. PLS 1206."

○ Found monument as note in Narrative.

( ) Plat distance.

Scale: 1" = 100'

REGISTERED PROFESSIONAL LAND SURVEYOR
James D. Hanley
OREGON
SEPTEMBER 23, 1977
JAMES D. HANLEY
1206

Renews June 30, 1997

MAP OF SURVEY

LOT 12, BLOCK 28
HUNTINGTON TOWNSITE,
IN HUNTINGTON, OREGON
Surveyed March 12, 1997
for the City of Huntington

FILED APRIL 14, 1997
BAKER COUNTY SURVEYOR
SURVEY NO. 14-44-21

HANLEY ENGINEERING
2043 MAIN STREET
BAKER CITY, OREGON