

Alpha-Num.  
Index # N-23

CERTIFIED RECORD OF LAND CORNER MONUMENTATION

**History of Original corner establishment:**

**DIAGRAM**  
**T14S R44E**  
**1/4 S 13**  
**S 24**  
**1997**  
**BAKER COUNTY**  
**SURVEYOR**

The original corner was set by Henry W. Cooke under GLO contract no. 427, dated December 15, 1881, as part of a subdivisional survey of T. 14 S., R. 44 E., W.M.

The original GLO notes state: Set a basalt stone 14x10x6 ins. 9 ins. in the ground for 1/4 sec. cor. marked 1/4 on N. face, dug pits and raised a mound of earth 1 1/2 ft. high, 3 1/2 ft. base alongside.

**Description of corner evidence found:**

Found a basalt stone 14"x10"x6" set firmly in the ground marked with a 1/4 on the North face of the stone. Also found a 1/2" i.d. galvanized pipe of unknown origin set firmly in the ground N. 4° E., 0.45' from the true corner position as determined by the original corner stone. The pipe was driven flush to ground level.

**Description of monument and accessories I established to perpetuate the original location of the corner**


At the position of the found corner stone set a 1 1/4" x 30" galvanized pipe with a 2 1/2" dia. brass cap 24" into the ground with a steel fence post alongside. The brass cap is marked as shown in the corner diagram. The original corner stone was buried 1 ft. North of the new monument.

Corner monument references: Four 1" x 2 1/2" magnets encased in plastic were set 6" below the ground. From the corner monument:

A silver magnet mkd. "1" bears N. 58 1/2° E., 11.1 ft. dist.  
A pink magnet mkd "2" bears S. 39° E., 7.6 ft. dist.  
A blue magnet mkd. "3" bears S. 58 1/2° W., 10.7 ft. dist.  
A orange magnet mkd. "4" bears N. 39° W., 11.2 ft. dist.

Staff compass declination: 13°.  
Reference survey see CS 14-44-18

I James D. Hanley certify that this corner was properly monumented as witnessed by Larry McBroom on August 19, 1997.

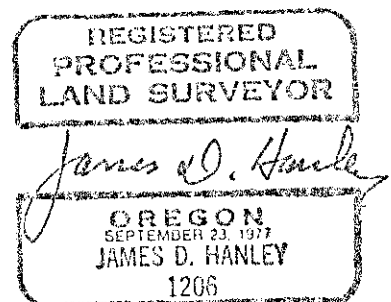

FILED OCT. 29, 1997  
BAKER COUNTY SURVEYOR  
SURVEY NO. 14-44-23

Renews June 30, 1999

10-29-97