MAP OF SURVEY

For Property Line Adjustment of
Lot 6, Block 46, Huntington Townsite
Huntington, Baker County, Oregon
SW1/4NE1/4 & SE1/4NW1/4 Section 13, T14S, R44E, WM

NARRATIVE

The purpose of this survey is to make a property line adjustment to Lot 6, Block 46, Huntington Townsite, Huntington, Baker County, Oregon which is owned by Bill Arnold which adds to the lot a 2 acre parcel in the SE1/4NW1/4 of Section 13, T14S, R44E, WM, owned by Janelle Quast.

The Huntington Townsite Plat was recorded on April 8, 1886, with Blocks 46-49 adjacent to the North-South center line of Section 13 which in part is the West city limits for the City of Huntington. The center of section line has been monumented at the Center 1/4 corner by unknown persons many years ago (possibly the Union Pacific Railroad) and the Center-North 1/16th corner was set by James Hambleton in 1975 during Baker County Survey No. 14-44-4. I found these two monuments which were used as control for and the basis of bearings for this survey.

The new lot lines were made parallel to the center of section line and the street bearings as determined from the original Huntington Townsite Plat and Survey No. 14-44-4.

CERTIFICATION

I, Leland Lee Myers, a Professional Land Surveyor registered in the State of Oregon, 587 E Auburn Street, PO Box 99, Sumpter, Oregon 97877, completed this survey on February 1, 2000 by setting the monuments and do hereby certify that the information shown on this plat is correct to the best of my knowledge.

REGISTERED
PROFESSIONAL
LAND SURVEYOR
Leland Lee Myers
OREGON
JULY 9, 1965
LELAND LEE MYERS
699

Renewal Date 1/1/01

30" long No. 5 Rebars with Yellow Plastic Caps marked PLS 699

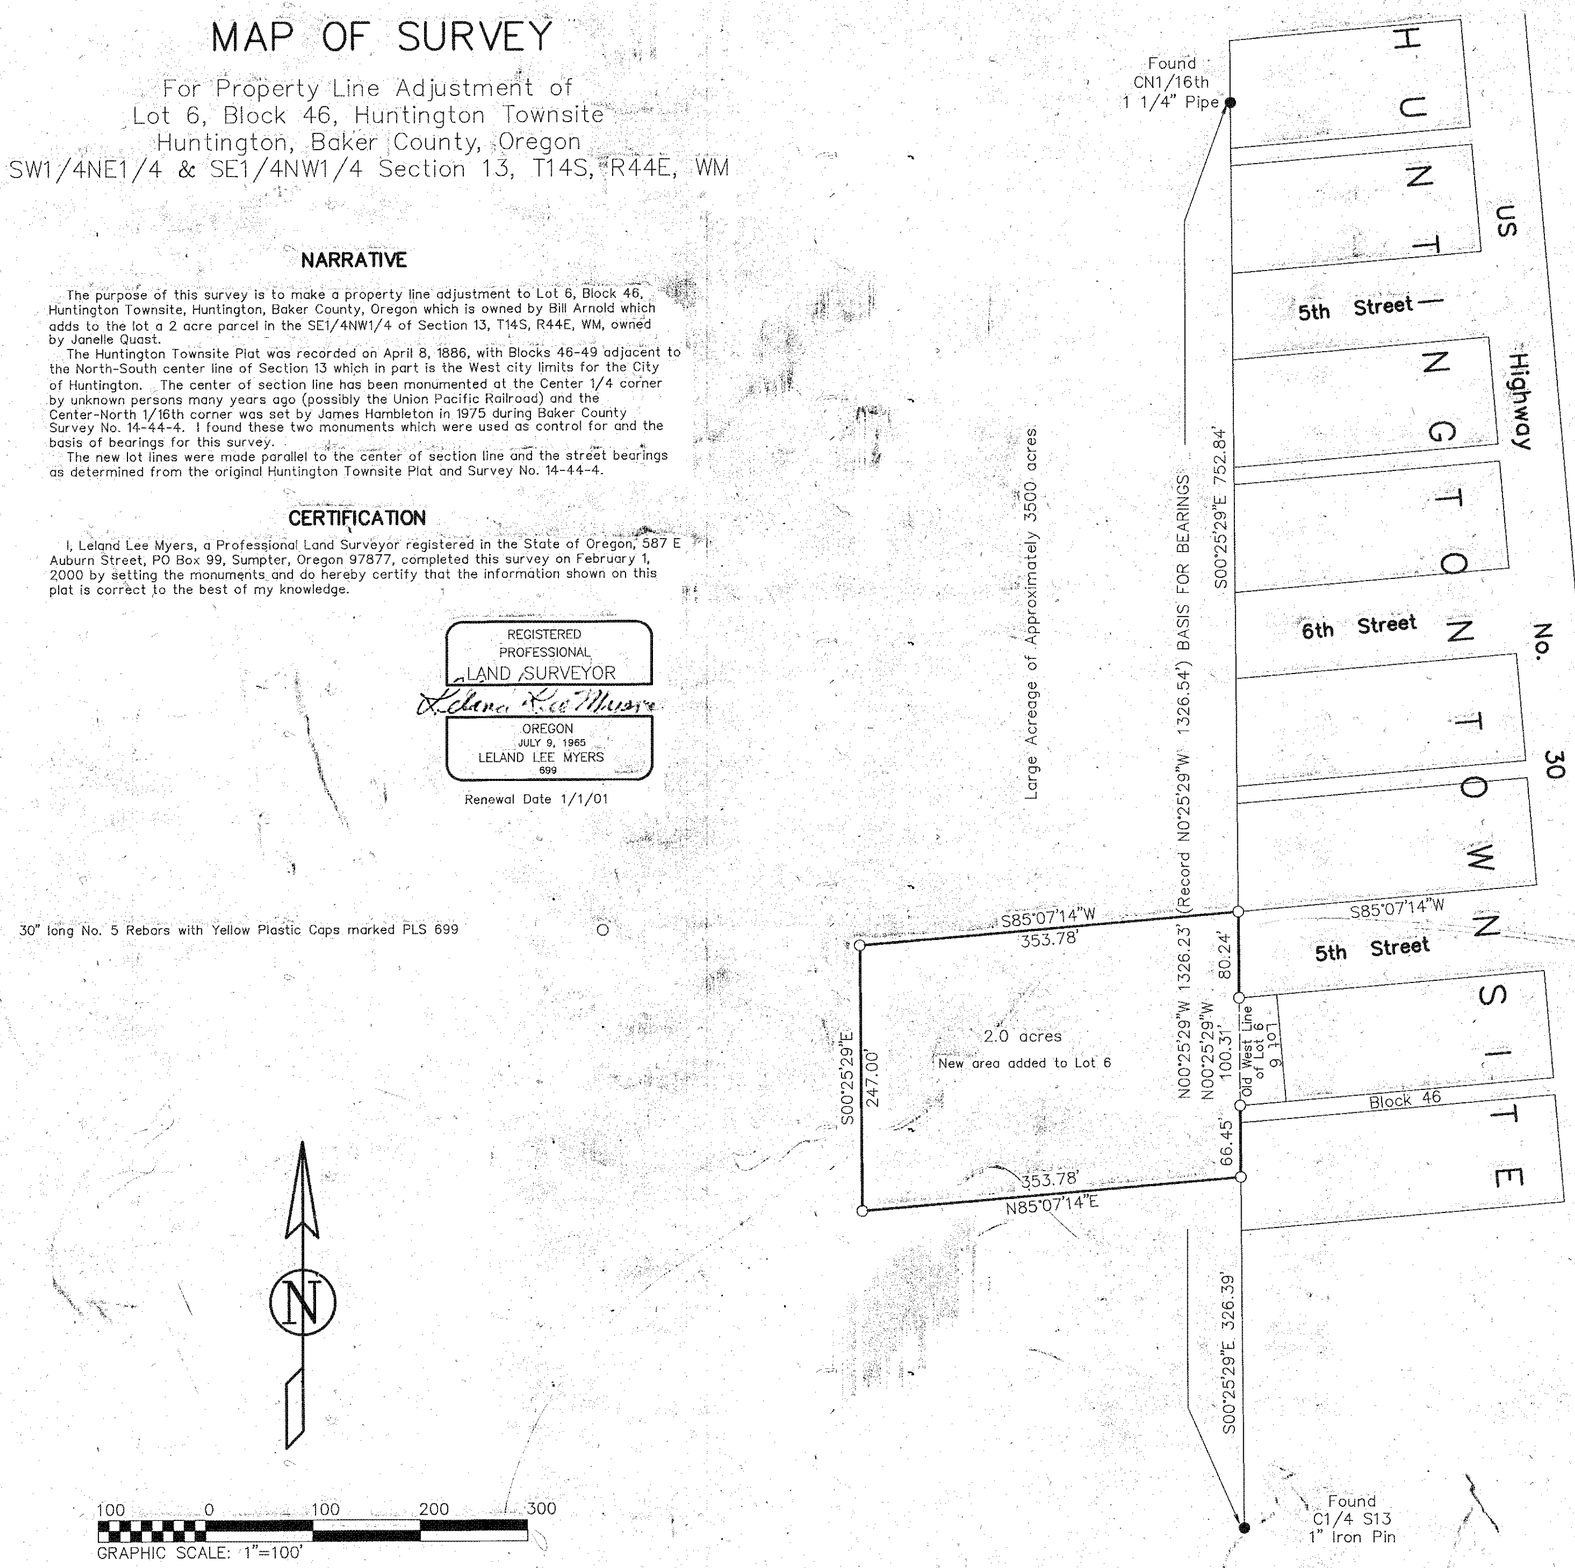

FILED MARCH 10, 2000
BAKER COUNTY SURVEYOR
SURVEY NO. 14-44-26