


HISTORY OF ORIGINAL CORNER ESTABLISHMENT:

Field notes of the Original Government Survey of the Subdivisions of Township 14 South, Range 44 East, surveyed by Henry W. Cooke, U.S. Deputy Surveyor, under Contract No. 427, dated December 15, 1881, state:

Set a basalt stone 12x10x6 ins., 8 ins. in the ground, for cor. to Sec's. 1, 2, 11, and 12 marked with 5 notches on S. and 1 notch on E. edges and raised stone mound alongside.

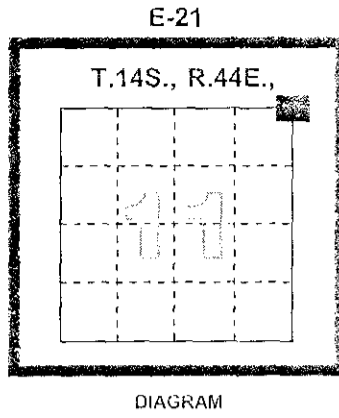


DESCRIPTION OF CORNER EVIDENCE FOUND:

Found a basalt stone, firmly set, exposed portion of stone is 8" by 10" in size, extending 14" above ground, with 5 prominent grooves on the South face and 1 prominent groove on the East face, surrounded in a mound of stone approx. 4 ft. in diameter.

This corner is located in an existing North-South fenceline, on an open SW facing slope, approximately 250 ft. North of a small grove of cottonwood trees.

DESCRIPTION OF MONUMENT AND ACCESSORIES ESTABLISHED TO PERPETUATE THE ORIGINAL LOCATION OF THIS CORNER:

No restorative work was performed at this corner location. This record has been prepared for informational purposes only.

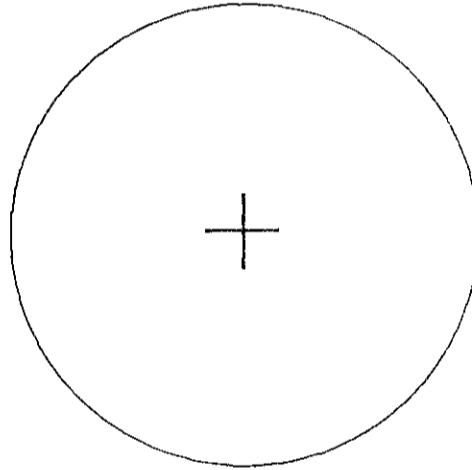

SPCS OREGON NORTH (International Feet)

Nothing Easting

I hereby certify that the above corner position was visited and found as hereon described on June 12, 2006.

Witnesses: Gary Langlitz

REGISTERED
PROFESSIONAL
LAND SURVEYOR

[Signature]

OREGON
JAN. 21, 1992
HARRON E. McLENDON
2937

6-12-06 12/13/06

FILED July 17, 2006
BAKER COUNTY SURVEYOR
SURVEY NO. 14-44-35