


CERTIFIED RECORD OF LAND CORNER MONUMENTATION

RECOVERED BY	COORDINATE SYSTEM, ZONE, & UNIT	
Matthew Faulkner, Oregon PLS	United States/NAD83, Oregon North 3601, International foot	
GCDB ID	NORTHING	EASTING
700160	252,286.30	9,048,127.03
LATITUDE	LONGITUDE	
N44°18'43.997"	W117°16'01.488"	

T. 14 S., R. 44 E.

W - 25

T. 14 S., R. 44 E.

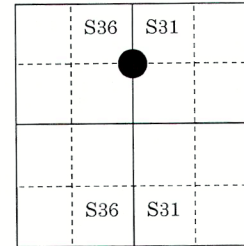

T. 14 S., R. 45 E.

RECORD OF ORIGINAL CORNER AND SUBSEQUENT HISTORY:

The N 1/16 sec. cor. of secs. 31 and 36, T. 14 S., Rs. 44 and 45 E., was originally established and described in the field notes of the dependent resurvey of a portion of the west boundary, T. 14 S., R. 45 W., Willamette Meridian, Oregon, by Cadastral Surveyors Peter A. Peterson, Leonard W. Murphy, Glenn F. Goodson, and Scott R. McIntyre, in 1977-79 under Group No. 902, Oregon.

Description: Point for the N 1/16 sec. cor. of secs. 31 and 36. Set an iron post, 28 ins. long, 2 1/2 ins. diam., 24 ins. in the ground, with brass cap mkd. N 1/16 S36 S31 1977.

DESCRIPTION OF CORNER EVIDENCE FOUND AND DESCRIPTION OF MONUMENT AND ACCESSORIES ESTABLISHED TO PERPETUATE THE LOCATION OF THIS CORNER:

Recovery Date: 6/12/2023

Description: The N 1/16 sec. cor. of secs. 31 and 36, T. 14 S., Rs. 44 and 45 E., monumented with an iron post, 2 1/2 ins. diam., firmly set, projecting 4 ins. above ground, with a witness mound of stone on the W. edge of the iron post (**Note:** Could not locate a record whereby this witness mound of stone was established but based on its age, it was most likely added during the BLM's 1977-79 resurvey of a portion of the Range line), 3 ft. base, 1 ft. high, with brass cap mkd. as shown below on this corner record and in the 1977-79 field notes.


FILED January 29, 2025
BAKER COUNTY SURVEYOR
SURVEY NO 14-44-46
14-45-39

CERTIFIED RECORD OF LAND
CORNER MONUMENTATION

Photo of the iron post monument and the witness mound of stone on the W. edge of the iron post.



Diagram of the brass cap markings.

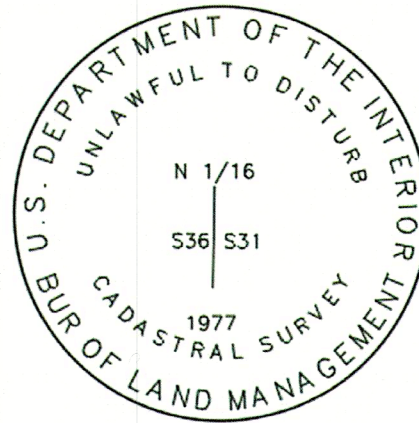

BAKER COUNTY SURVEYOR	
Date Received	_____
Date Filed	January 29, 2025
By	_____
File No.	14-44-46 14-45-39

REGISTERED PROFESSIONAL LAND SURVEYOR

OREGON JUNE 08, 2009 MATTHEW J. FAULKNER 75618LS

RENEWS: 12/31/25