T.14S. R.45E. W.M. ORE.
BAKER COUNTY
OREGON

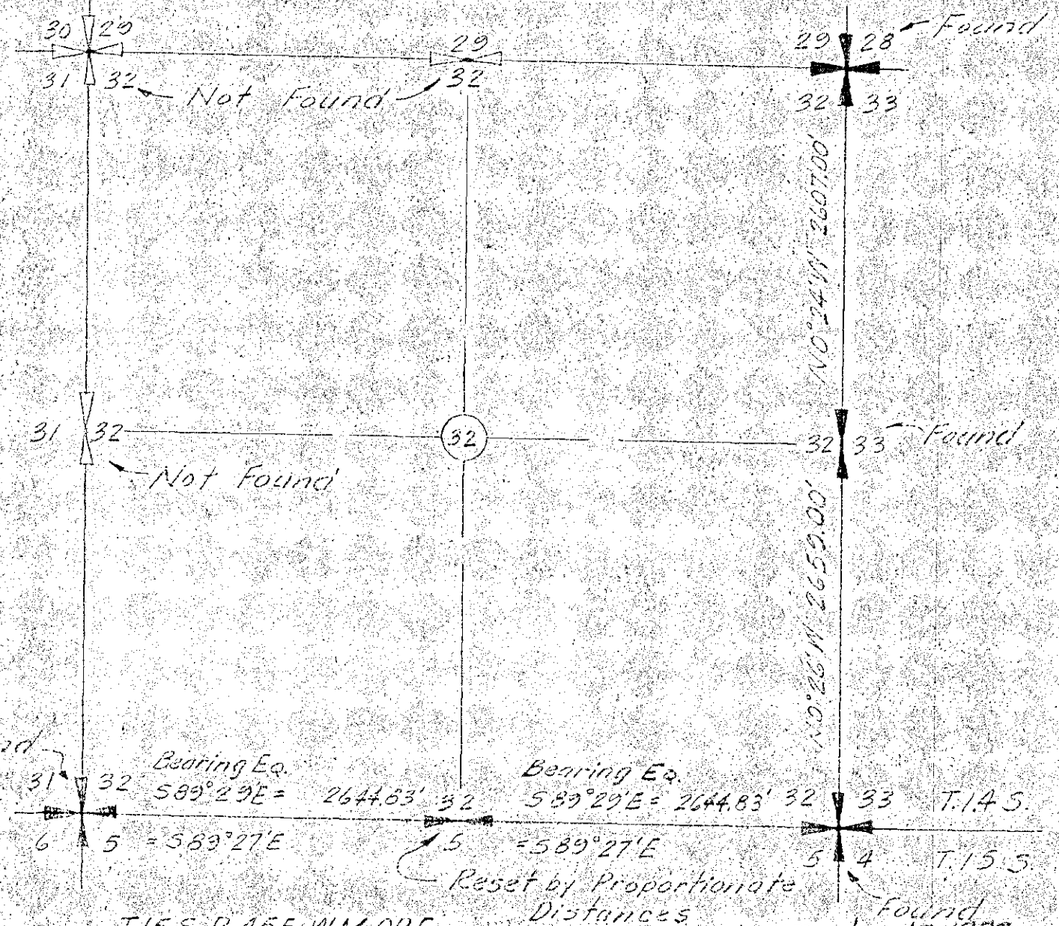

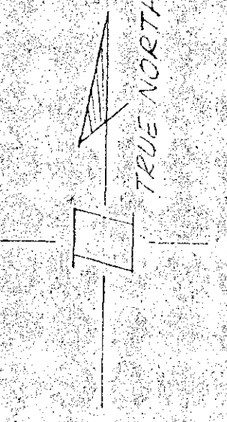

REGISTERED
OREGON
LAND SURVEYOR
L. G. BURNAP
366

B-5K-37

BROWNLEE H.E. DEVELOPMENT
DEPENDENT RESURVEY of
Sec. 32 T.14S. R45E. W.M. ORE.

IDAHO POWER CO.
BOISE, IDAHO

SCALE: 1" = 1000' 4-30-58

D.R.	D.D.	APPROVED
T.R.		

20R-16717

FILED Jan. 10, 1977
BAKER COUNTY SURVEYOR
SURVEY NO. 14-45-3

T.15S. R.45E. W.M. ORE.
MALHEUR COUNTY
OREGON

K-216

16-2