


SURVEY NARRATIVE

No monumentation was recovered South of Monroe Street. Therefore, control was projected from recovered monumentation for Huntington Townsite Addition using plat distances for First Addition to Huntington. Records of the width of Fulton Street were indefinite. A width of 70 feet was used as this width conforms to existing sidewalks, presumably constructed when monumentation did exist.

Find. Brass disc at First St (W) & Monroe.

Find. 1" I.P. at Sixth St. (E) & Monroe.

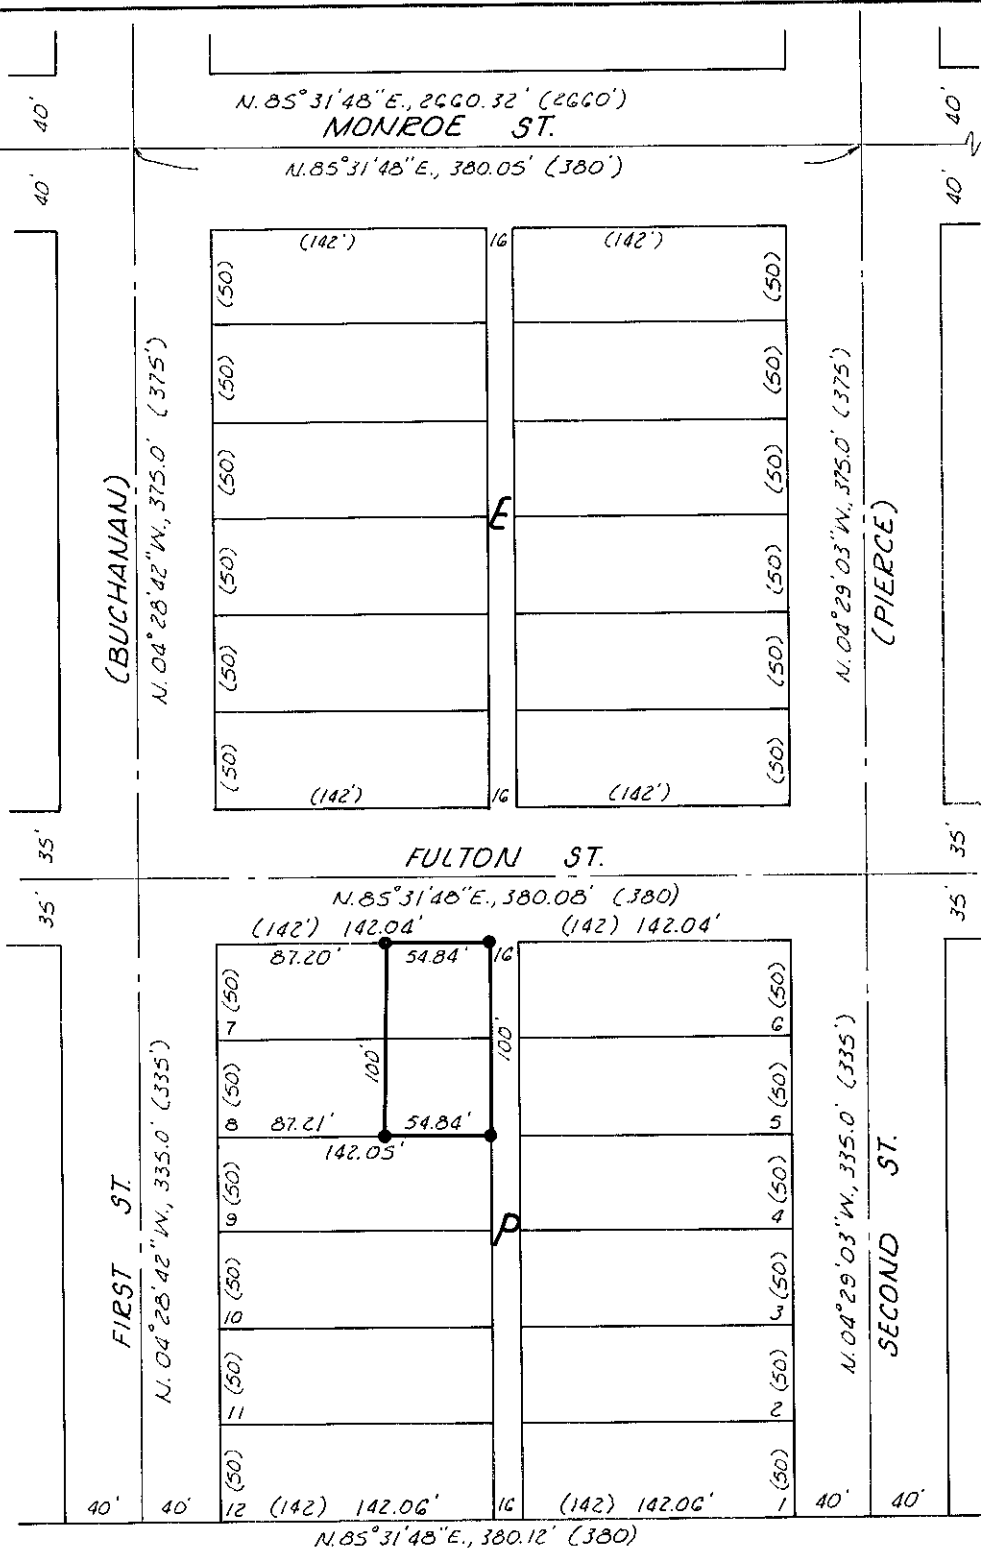

LEGEND
 • Found monument as noted
 ● Set 5/8" x 30" rebar
 () Record of original plat

Johnson St. bears S. 04° 28' E. as noted on Philo Anderson map of 1954.

Reference Survey No. 14-44-G

MAP OF SURVEY
 IN BLOCK P, FIRST ADDITION TO HUNTINGTON
 HUNTINGTON, OREGON
 Surveyed April 1, 1982 Scale 1"=100'
 For Jack Moore

FILED April 6, 1982
 BAKER COUNTY SURVEYOR
 SURVEY NO. 14-45-7

**REGISTERED
 PROFESSIONAL
 LAND SURVEYOR**

William L. Hanley

OREGON
 JULY 14, 1978
 WILLIAM L. HANLEY
 1639