


**LEGEND**

- Monument of record
- Set  $\frac{3}{8}$ " 30" rebar
- ( ) Record of original plat

*Johnson St. bears N. 04° 28' W. as noted on Philo Anderson map of 1954.*

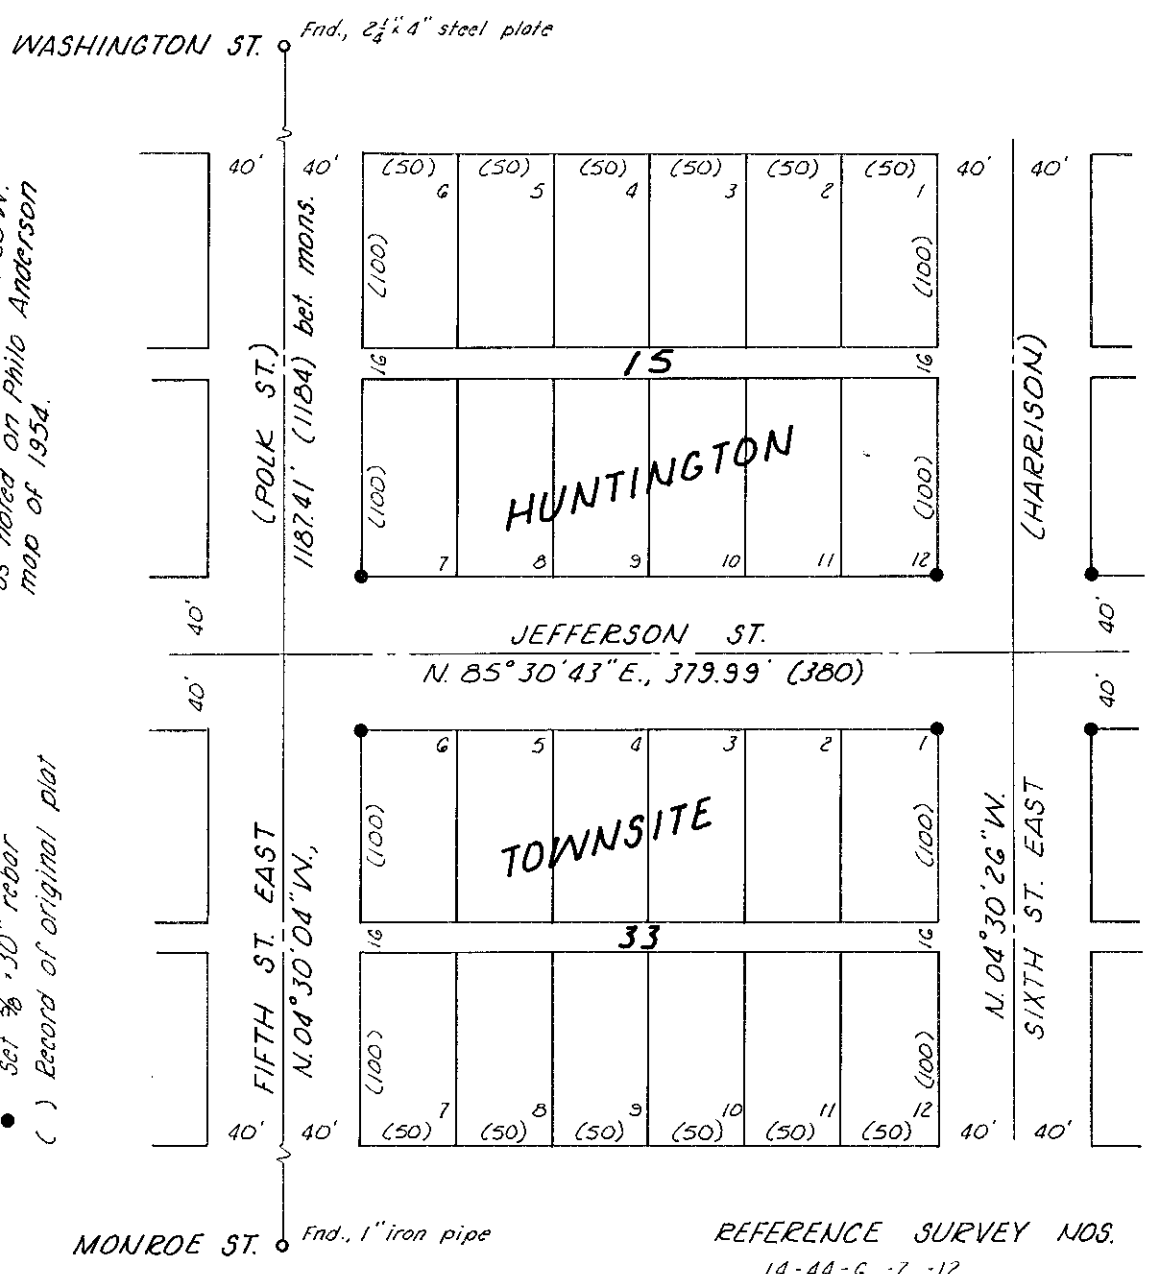

REFERENCE SURVEY NOS.  
14-44-C, -7, -12  
14-45-5, -6

**SURVEY NARRATIVE**

This survey was performed at the request of the City of Huntington for the purpose of monumenting Jefferson Street between Fifth Street East and Sixth Street East. Survey control from previous surveys of Huntington Townsite Addition was recovered and monuments established at their proportioned positions.

**MAP OF SURVEY**  
JEFFERSON STREET BETWEEN BLOCKS 15 & 33,  
HUNTINGTON TOWNSITE ADDITION TO HUNTINGTON, OREGON

Surveyed April 1, 1982 Scale 1"=100'

For the City of Huntington

FILED April 6, 1982  
BAKER COUNTY SURVEYOR  
SURVEY NO. 14-45-8

**REGISTERED  
PROFESSIONAL  
LAND SURVEYOR**

*William L. Hanley*

OREGON  
JULY 14, 1978  
WILLIAM L. HANLEY  
1639