

CERTIFIED RECORD OF LAND CORNER MONUMENTATION


A-9

History of original corner establishment:

John Meldrum surveyed the north township line of T15S R45E under contract No. 204.

Record states:

Set stone 16"x10"x8" marked with 4 notches on the east and 2 notches on the west edges.

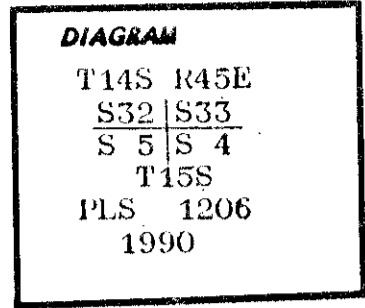

Description of corner evidence found:

Found scattered remains of a stone mound.

Description of monument and accessories established to perpetuate the original location of this corner:

At the corner point as retraced from O.S.H.D. drawing No. 8B-25-6, set 2½" brass cap on 1¼" O.D. iron pipe 30" long, 22" into the ground, with cap marked as shown in the corner diagram. Constructed 36" dia. stone mound around the monument.

From which: references set

- A 5/8"x30" rebar bears N 45 E 25.0 feet, with plastic cap marked "NE HANLEY ENGR. PLS 1206.
- A 5/8"x30" rebar bears S 45 E 25.0 feet, with plastic cap marked "SE HANLEY ENGR. PLS 1206.
- A 5/8"x30" rebar bears S 45 W 25.0 feet, with plastic cap marked "SW HANLEY ENGR. PLS 1206.
- A 5/8"x30" rebar bears N 45 W 25.0 feet, with plastic cap marked "NW HANLEY ENGR. PLS 1206.

Note No. 1

The corner point and references are located approximately 5 feet below the high water line of Brownlee Reservoir.

Note No. 2

A U.S. Coast and Geodetic Survey Marker "Benson No. 1 1945" bears N 24 W 1.53 feet from the corner point. It is coincidental that Benson No. 1 is so close to the retraced section corner point. The description of Benson No. 1 reads "Reference mark No. 1 is 30 feet west of a fence corner and 2 feet north of a fence line". This information gotten from The U.S. Geological Survey Dept. National Mapping Division.

Note No. 3

O.S.H.D. drawing No. 4-B-13-2 and Idaho Power drawing No. E-11441 also have the section corner located. Both positions as retraced land within 4.5 feet of the monumented position as described above.

I certify that the above monument was properly set under my direct supervision as witnessed by Tom Fisk and Larry McBroom. March 1, 1990.

Office of..... County of.....
 State of....., I hereby certify that the within instrument was filed in this office
 for record on the..... day of....., 19.....
 by (DEPUTY)
 (COUNTY OFFICIAL)

Form R6-7100-57 (9/71)

REGISTERED
 PROFESSIONAL
 LAND SURVEYOR

OREGON
 SEPTEMBER 23, 1977
 JAMES D. HANLEY
 1206

★ GPO-789-278

FILED May 10, 1990
 BAKER COUNTY SURVEYOR
 SURVEY NO. 14-45-11