
ADAMS STREET

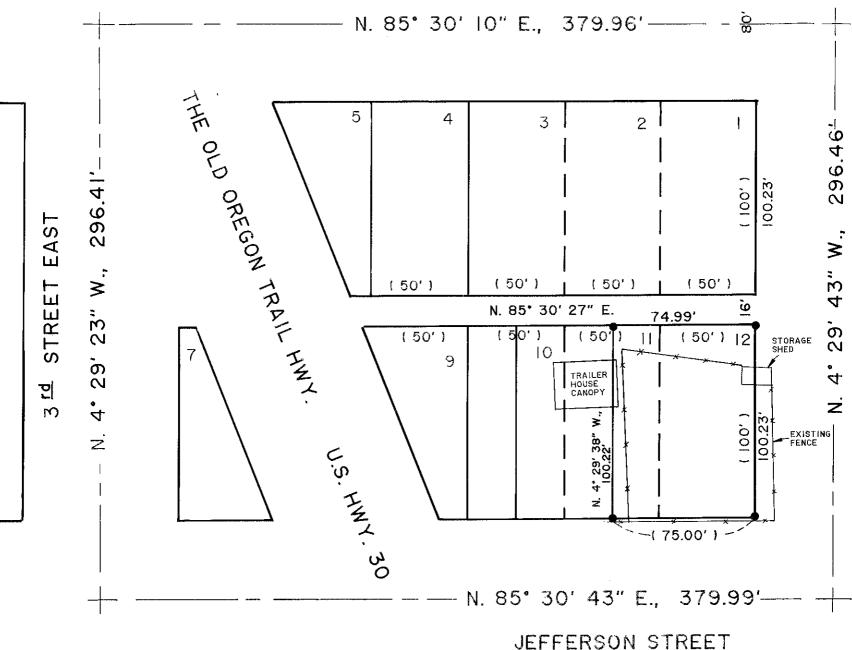

80'

NARRATIVE

80

The purpose of this survey for Floyd Ingram is to mark in the ground the East 1/2 of Lot II and all of Lot 12, E.K. 17, Huntington Townsite. The original map of Huntington is filed in County Plat Book No.1, Page 48, dated April 8, 1886. The plat describes "four permanent corners having been established at points "A", "B", "C", and D". All monumentation marking these points was recovered, consisting of the following: "A" monument at 1 st and Mashington is now a 5/8 inch rebar; "B" monument at 6 thand Washington is the original 2 1/2 inch X 4 inch steel plate; "C" monument at 6 th and Monroe is now a inch diam. Iron rod; "D" monument at 1 st and Monroe is now a 2 1/2 inch diam. brass cap in concrete. Further explanation is found in survey 14-44-14. The record searing between "A" and "D" of N. 04° 28' E. is held this survey.

BASIS OF BEARING I st Street between point "A" and "D" as described in the

Set 5/8" X 30" rebar with marked "HANLEY ENGR. PL

Record plat distance

EGEND

SCALE: I" = 50'

80'

SURVEY TIES

From the intersection of 3rd street E. and Adams Street:

Monument "A" bears N. 04° 29' 23" W., 296.67 feet along 3rd Street E. centerline to Washington Street centerline; thence S. 85° 29' 57" W., 1519.71 feet along Washington Street.

Monument "B" bears N. 85° 29′ 57" E., 1139.77 feet from 3rd Street E. and Washington Street centerlines intersection.

Monument "A" to monument "B" is N. 85° 29' 57" E., 2659.48 feet.

MAP OF SURVEY E1/2 Lot 11, all of Lot 12, BLK. 17

HUNTINGTON TOWNSITE
IN HUNTINGTON, OREGON
Surveyed Jan. 24, 1996
for Floyd Ingram

FILED 2-20-96

BAKER COUNTY SURVEYOR

SURVEY NO 14-45-15

HANLEY ENGINEERING 2043 MAIN STREET BAKER CITY, OREGON REGISTERE PROFESSIO LAND SURVI

OREGO: SEPTEMBER 23, 19 JAMES D. HANI 1206

Renews June 30