


NARRATIVE

The purpose of this survey for Dean Pollard is to mark on the ground the corners of Lots 1-9, Block 8, Huntington Townsite. The original map of Huntington is filed in County Plat Book No. 1, Page 48, dated April 8, 1886. The plat describes four permanent corners having been established at points "A", "B", "C" and "D". All monumentation marking these points was recovered; consisting of the following: "A" monument at 1st and Washington is now a 5/8 inch rebar; "B" monument at 6th and Washington is the original 2 1/2 inch X 4 inch steel plate; "C" monument at 6th and Monroe is now a 1 inch diam. iron rod; "D" monument at 1st and Monroe is now a 2 1/2 inch diam. brass cap in concrete. Further explanation is found in Survey 14-44-14. The record bearing between "A" and "D" of N. 04° 28' W. is held this survey.

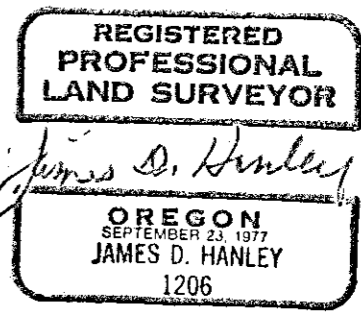

Renews June 30, 1997

MAP OF SURVEY LOTS 1 - 8 & W1/2 OF 9, BLK. 8 HUNTINGTON TOWNSITE, IN HUNTINGTON, OREGON

Surveyed March 12, 1997
 for Dean Pollard
 Scale: 1" = 100'

LEGEND

- Set 5/8" X 30" rebar w/ plastic cap marked "HANLEY ENGR. PLS 1206."
- Found monument as noted in narrative.
- () Plat distance.

HANLEY ENGINEERING
 2043 MAIN STREET
 BAKER CITY, OREGON

FILED APRIL 14, 1997
 BAKER COUNTY SURVEYOR
 SURVEY NO. 14-45-16