RECORD OF SURVEY FOR THE HUNTINGTON SCHOOL DISTRICT IN BLOCK Q IN THE FIRST ADDITION TO THE CITY OF HUNTINGTON WITHIN GOVT. LOT 4, AND THE SE1/4SW1/4, SECTION 18, T14S, R45E, W.M. CITY OF HUNTINGTON, BAKER COUNTY, OREGON

REFERENCES:

(1) MAP OF HUNTINGTON, FILED DEC. 24, 1886.
(2) MAP OF THE FIRST ADDITION TO HUNTINGTON OF 1891.
(3) RECORDS OF SURVEY BY HANLEY ENGINEERING SURVEY NUMBER 14-45-19.
(4) RECORD OF SURVEY BY EDWARDS & CUMMINGS, SURVEY No. 14-45-20
(5) PARTITION PLAT No. P2001-003, BY EDWARDS & CUMMINGS, SURVEY No. 14-45-21

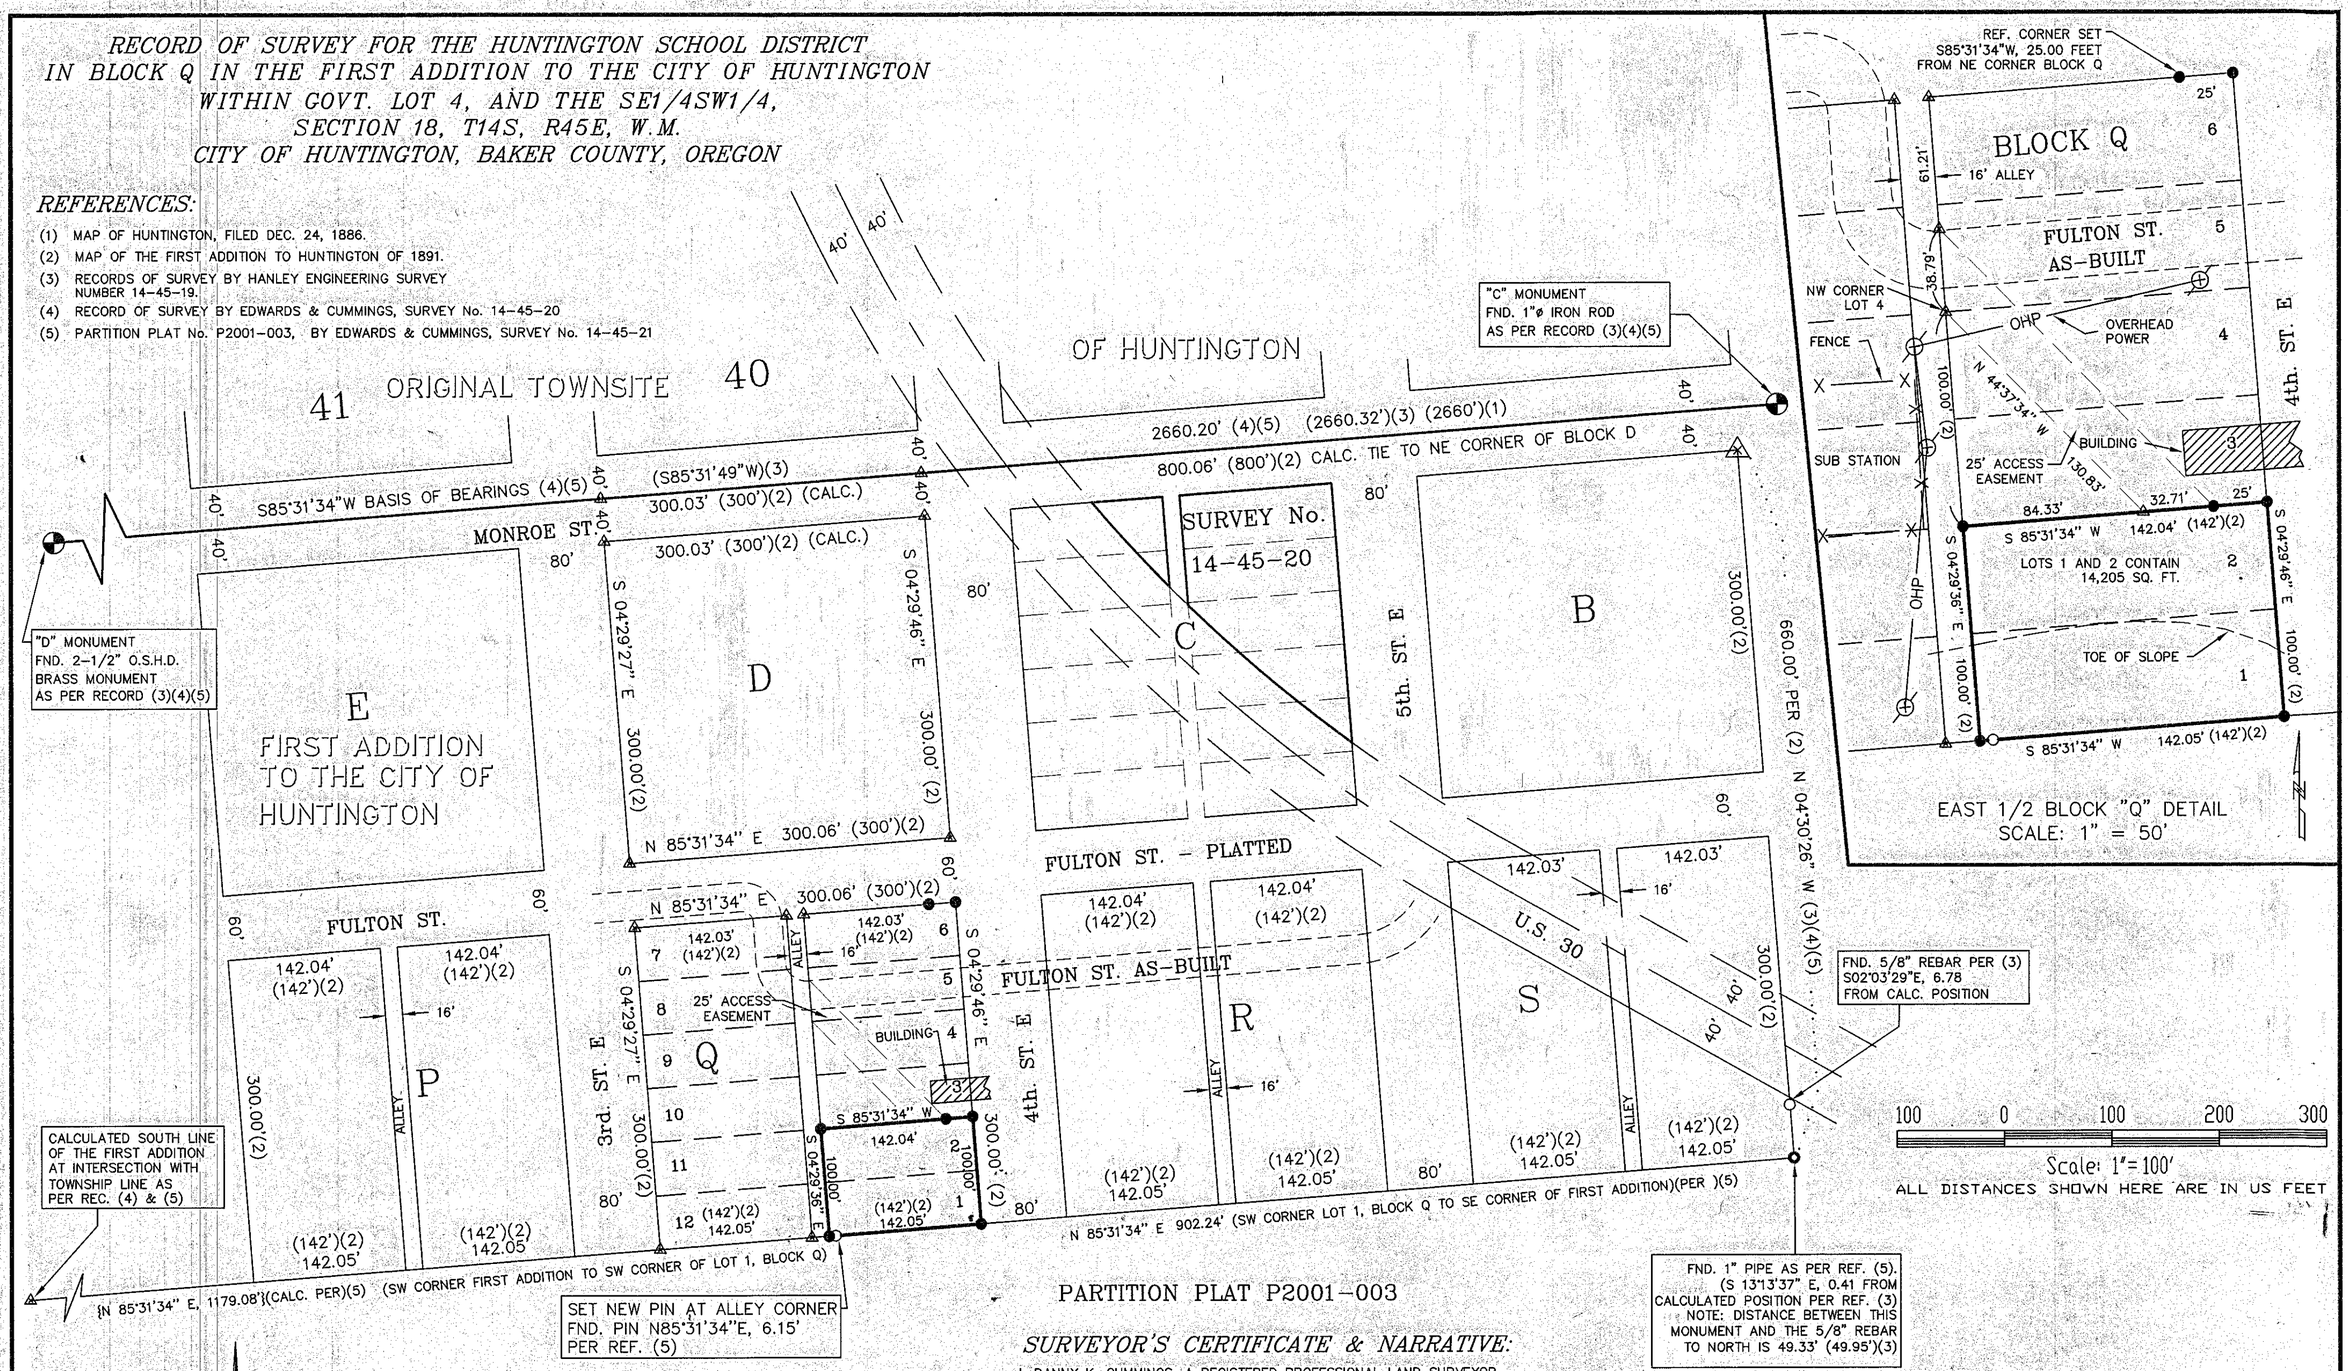

PARTITION PLAT P2001-003

SURVEYOR'S CERTIFICATE & NARRATIVE:

I, DANNY K. CUMMINGS, A REGISTERED PROFESSIONAL LAND SURVEYOR, HEREBY CERTIFY THAT THIS PLAT REPRESENTS A SURVEY DONE BY ME, OR UNDER MY DIRECTION, THAT THE MONUMENTS ARE AS SHOWN, AND THAT THIS PLAT IS A TRUE AND ACCURATE REPRESENTATION OF THAT SURVEY.

THIS SURVEY WAS DONE AT THE REQUEST OF GERALD HOPKINS, SUPERINTENDENT FOR THE HUNTINGTON SCHOOL DISTRICT, TO MONUMENT LOTS 1 AND 2, IN BLOCK Q, OF THE FIRST ADDITION TO HUNTINGTON. BLOCK Q WAS ESTABLISHED FROM FOUND MONUMENTS, AND RECORD DATA, AS SHOWN. FOR ADDITIONAL INFORMATION, PLEASE REFER TO THE REFERENCE SURVEYS NOTED HEREON.

THE SURVEY WAS COMPLETED ON 8/22/2001.

REGISTERED PROFESSIONAL LAND SURVEYOR
Danny Cummings 9-13-01
OREGON JAN. 21, 1988 DANNY K. CUMMINGS 2316

RENEWAL DATE: 12-31-01

FILED September 28, 2001

BAKER COUNTY SURVEYOR

SURVEY No. 14-45-22

LEGEND

LINE SURVEYED	
PLAT CONTROL LINE (1)(4)(5)	
SECTIONAL LINE	
CALCULATED DATA	( )
OF RECORD	( )
MONUMENT AS NOTED	⊕
SET 5/8"X30"REBAR	●
FOUND 5/8" REBAR AS NOTED	○
FOUND 1" IRON PIPE	⊙
CALCULATED POINT	△

SURVEY FOR: HUNTINGTON SCHOOL DISTRICT

EDWARDS & CUMMINGS LLC
CIVIL/STRUCTURAL ENGINEERING & LAND SURVEYING, GPS SERVICES
156 S.E. 1ST AVE., SUITE 1 & 2
ONTARIO, OREGON 97914
OFFICE: (541) 889-5411
FAX: (541) 889-2074
P.O. BOX 1485
82077 HWY. 395 N.
UMATILLA, OREGON 97882
OFFICE: (541) 922-3085
FAX: (541) 922-3085

CHECKED BY: DKC	DRAWN BY: RGH	APPROVED BY: DKC
DATE: 9/12/2001	DRAWING No. S001056- B-908	REVISED:
SHEET 1 OF 1	JOB No. S0-01056	BK. 0- PG.