

# CORNER RESTORATION FORM

Township 14S Range 45E Section 18 County BAKER

State OREGON Date 9/27/16 Number L-03

Corner Designation : C<sup>1</sup>/<sub>4</sub> CORNER, SECTION 18

Previous Renewals \_\_\_\_\_

Monument (s) Found: \_\_\_\_\_ (Condition and Source)

FOUND A 1" I.D. IRON PIPE FLUSH WITH GROUND, IN A SMALL MOUND OF STONES.

Accessories Found: \_\_\_\_\_

NO ACCESSORIES WERE FOUND

Monument & Accessories Set (Procedure and Description)


A #5 REBAR/AL. CAP WAS SET THROUGH THE PIPE AND DRIVEN TO GRADE. A MOUND OF STONES WAS REHABILITATED AROUND THE NEW MONUMENT.

- ① A #4 REBAR WAS SET APPROXIMATELY 0.3' BELOW GRADE, 8.96' NW OF THE CORNER
- ② A #4 REBAR WAS SET APPROXIMATELY 0.3' BELOW GRADE, 7.24' NE OF THE CORNER.
- ③ A #5 REBAR WITH AL. CAP WAS SET 58.67' NORTH OF THE CORNER.


Condition Report Only  
 Not Found  
 Renewed  
 Surveyed In  
 Referenced

### MONUMENT DETAIL

Found  Set

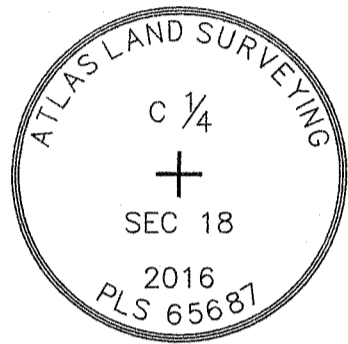

### Sketch of Monument, Accessories and General Area

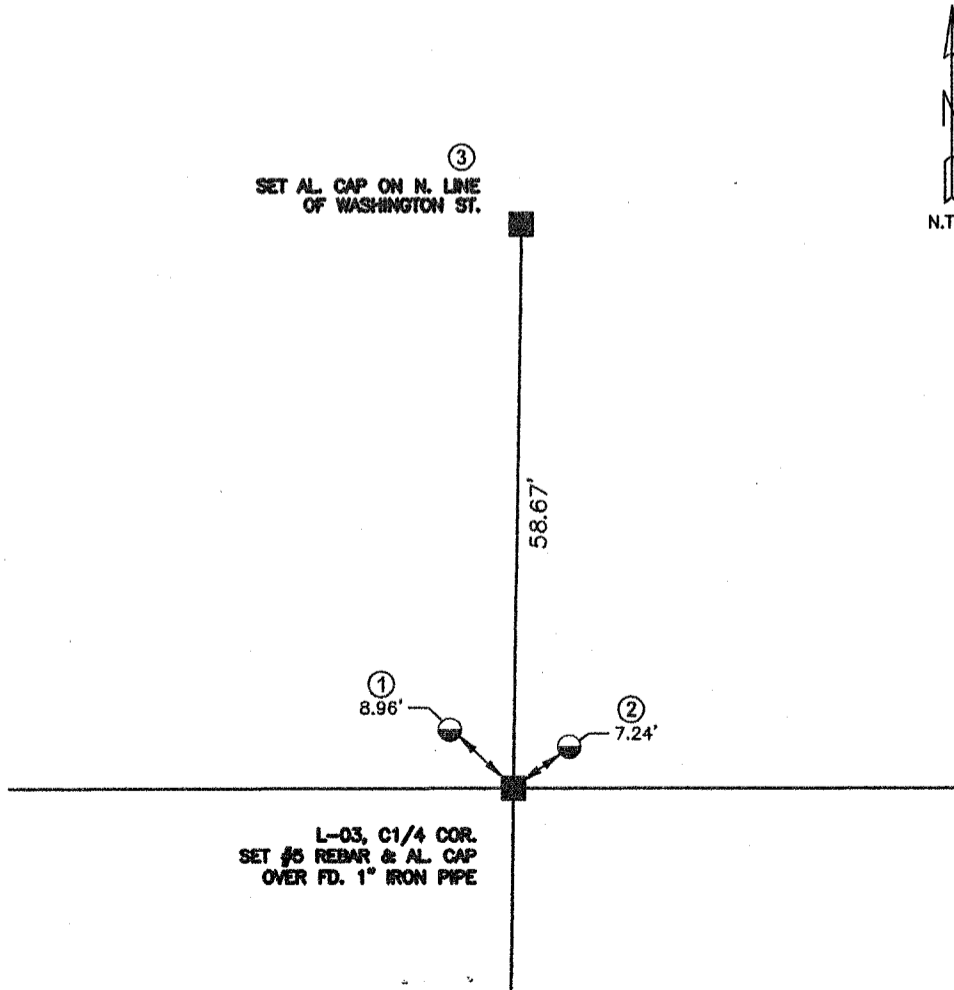

Surveyor's Seal

REGISTERED PROFESSIONAL LAND SURVEYOR

*Dean J. Coon*

OREGON  
 JANUARY 8, 2002  
 DEAN J. COON  
 65687LS

EXPIRES: 12/31/17

Agency ATLAS LAND SURVEYING



206 NW 9TH STREET  
 FRUITLAND, ID 83619

Party Chief D. COON

Notekeeper D. COON

Job No. 16-029A-TS-HE

Field Book 14452-01; p. 09

Date of Work 07/19/16

COUNTY SURVEYOR FILING INFORMATION

By \_\_\_\_\_

Received Oct. 15, 2016

Filed \_\_\_\_\_

Survey No. 14-45-00 33

Dwg. No. N/A

Index No. L-03