

CERTIFIED RECORD OF LAND CORNER MONUMENTATION

History of original corner establishment:


Corner was established by George R. Campbell, US Deputy Surveyor, during the original survey Contract No. 724 dated September, 1900.

Set a basalt stone 20x10x8 ins. 15 ins. in the ground for cor. of secs 2, 3, 10 and 11, marked with 5 notches on the S and 2 notches on the E edges from which

- A white fir 15 ins diam bears S58°30'E, (55.4')84 lks. dist marked T15SR35E S2 BT
- A black pine 20 ins diam bears S65°13'E, (35.0')53 lks. dist marked T15SR35E S11 BT.
- A white fir 9 ins diam bears S82°30'W, (4.0')6 lks. dist marked T15SR35E S10 BT
- A white fir 9 ins diam bears N3°30'W, (25.1')38 lks. dist marked T15SR35E S3 BT

DIAGRAM

T15S R35E

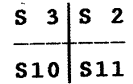

1991
PLS 699

Description of corner evidence found:

Found the marked corner stone, two BTs and root holes for the other two BTs. This corner falls in the Glacier Complex forest fire and all trees are dead.

- Root hole (1900 BT) bears at SE record
- 14" fire killed Lodgepole pine (Dead)(Scribing Visible)(1900 BT) bears S66°E, 35.4 feet.
- Root hole (1900 BT) bears at SW record
- 12" fire-killed Alpine fir (Dead)(Scribing Visible)(1900 BT) bears N2°15'W, 25.0 feet.

Description of monument and accessories I established to perpetuate the original location of this corner:

Set a 2"x30" aluminum pipe with a 2½" aluminum cap, marked as shown in the diagram, 26" in the ground, replacing the rock which is turned upside down and buried on the north side of the monument. Built a mound with earth & rock to be 30" in diameter by 4" high around the monument, from which new BTs are:

- 9" fire-killed and sawed off Alpine fir bears N68°E, 7.7 feet scribed T15SR35E S2 BT
 - 10" fire-killed and sawed off Alpine fir bears S57°15'W, 39.8 feet scribed T15SR35E S10 BT
- Sawed off the dead BTs about 6' above the ground. Attached BT and an Attention signs to and painted a red band around each BT. Bearings were turned from the control traverse with a theodolite, basis of bearing being a solar observation that was made on the adjacent McCoy Cadastral Survey contract in 1987, to stamped aluminum washers nailed on new BTs in the scribed red-painted blazes or to the red-painted blazes or scars on old BTs. Distances were measured from a 60d spike, with an aluminum washer stamped PLS 699, which was driven into the side of each BT approximately one foot above the ground.
- Set steel fence posts 5.6 feet W and 5.4 feet N of the corner on the National Forest boundary lines. Attached Forest Boundary signs to each post and an Attention sign to the W post.


I, Leland L. Myers, 587 E. Auburn St., P.O. Box 98, Sumpter, OR 97877, do hereby certify that on October 15, 1991, I monumented the corner as herein described.

FILED

IN THE OFFICE OF THE Baker COUNTY SURVEYOR

THIS _____ DAY OF _____, 19____

Baker County Surveyor

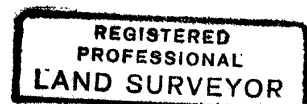

Leland L. Myers
OREGON
JULY 9, 1965
LELAND LEE MYERS
699

FILED Dec. 4, 1991
BAKER COUNTY SURVEYOR
SURVEY NO. 15-35-1