

CERTIFIED RECORD OF LAND CORNER MONUMENTATION

1 of 2

History of original corner establishment:

Corner originally established by John Hagel under Mineral Survey No. 427 and surveyed under instructions dated July 8, 1901.

Original notes state:

Identical with cor. 2 of "Luxemburg" Quartz Claim Sur. 428.

Set a black pine post 5 ins. square, 4 1/2 ft. long, 18 ins. in the ground with a mound of earth around it, scribed Alta Q. Cl. C.2-427.

A spruce tree 5 ins. diam. bears S34°15'E, 9.8 ft.
A black pine tree 12 ins. diam. bears S78°E, 11.8 ft.
both blazed and scribed Alta Q.Cl. C.2-427 BT.

Corner established by: John Hagel under Mineral Survey No. 428 and dated July 10, 1901.

Record states:

Identical with the Corner No. 2 of the "Alta" Quartz Claim, survey 427.

A black pine post 5 ins. square, 3 ft. above the ground, with a mound of earth around it, scribed Alta Q.Cl. C.2-427. Scribed it Lux.Q.Cl. C.2-428.

Corner remonumented by: William R. Wells, per Corner Record 8-36-69, filed 3-24-93.

Found rotted remains of post below ground level, from which...

A 38" spruce brs S34 1/4°E, 9.8' with healed blaze. (Original BT)
A 18" lodgepole pine brs S78°E, 11.7' with scribes visible on a previously opened blaze. (Original BT)

At position of found post remains...

Set 2 1/2" x 30" aluminum pipe with a 2 1/2" aluminum cap 28" in ground and surrounded with a mound of earth and stone. Cap marked as shown in corner diagram.

New bearing trees established:

A 22" western larch brs N58°W, 49.9' scribed 2-A-427/2-L-428 BT.
A 17" western larch brs S63 1/2°W, 45.0' scribed 2-A-427/2-L-428 BT.

New bearing trees have a brass washer stamped PLS 1106 nailed to face of blaze. Attached sign 54-3 & 54-9 to each BT & painted face of blaze & 6" red band around each BT. Set steel fence post on National Forest Boundary SW of corner with sign 54-2 & 54-9 attached.

Compass declination 18° East.

I hereby certify that the above corner was properly remonumented by me to U.S.F.S. standards on September 15, 1992.

Continued on page 2 of 2

REGISTERED
PROFESSIONAL
LAND SURVEYOR



OREGON
MAY 9, 2017
KRISTINA POWELL
91201

EXPIRES 12-31-24

FILED January 3, 2024
BAKER COUNTY SURVEYOR
SURVEY NO. 8-36-99

CERTIFIED RECORD OF LAND CORNER MONUMENTATION

Description of corner evidence found:

A 2 1/2 inch aluminum pipe with a 2 1/2 inch aluminum cap, marked as shown. Firmly set, flush with ground.

From which:

An 18 inch pine snag (by Hagel) scribed "QCLC2 427 BT", dead and down, bears S78°E, 11.7 feet to stump hole.

A 42 inch spruce (by Hagel) with healed blaze, bears S34 1/2°E, 9.8 feet, alive and healthy.

A 17 western larch snag (by Wells) dead and down with visible scribing, bears S63 1/2°W, 45.0 feet to stump hole.

A 29 inch western larch (by Wells) with healed blaze, bears N58°W, 49.9 feet, alive and healthy.

A steel T-post bears N56°E, 10.0 feet; with sign: Property Boundary

A steel T-post bears S42°W, 5.0 feet; with two (2) signs: Property Boundary, Land Survey Monument.

Monument falls East 205 feet of the 075 Road.

Description of monument and accessories I established to perpetuate original location of this corner:

New Bearing Tree:

A 7 inch white fir scribed "X BT" on single blaze, bears N53°E, 48.1 feet; measured to a 3/4 inch brass washer mkd: "LS 91201", at the right side of tree center.

Added Bearing Tree and Land Survey Monument signs as needed.

NAD 83 Geodetic Position

Lat. 44°49'16.6" N
Long. 118°15'29.3" W

Established by: Garmin ETREX 32x

I hereby certify that the corner is monumented and accessories taken as described using a steel tape and a Warren Knight staff compass, set with a declination of 14° East.

Witnesses: David Quittschreiber, Justin Seal, Shar Hutchison

August 9, 2023

2 of 2


T 8 S R 36 E

MS 427 / MS 428

2 A / 2 L

Luxemburg Cor. 2

Alta Cor. 2

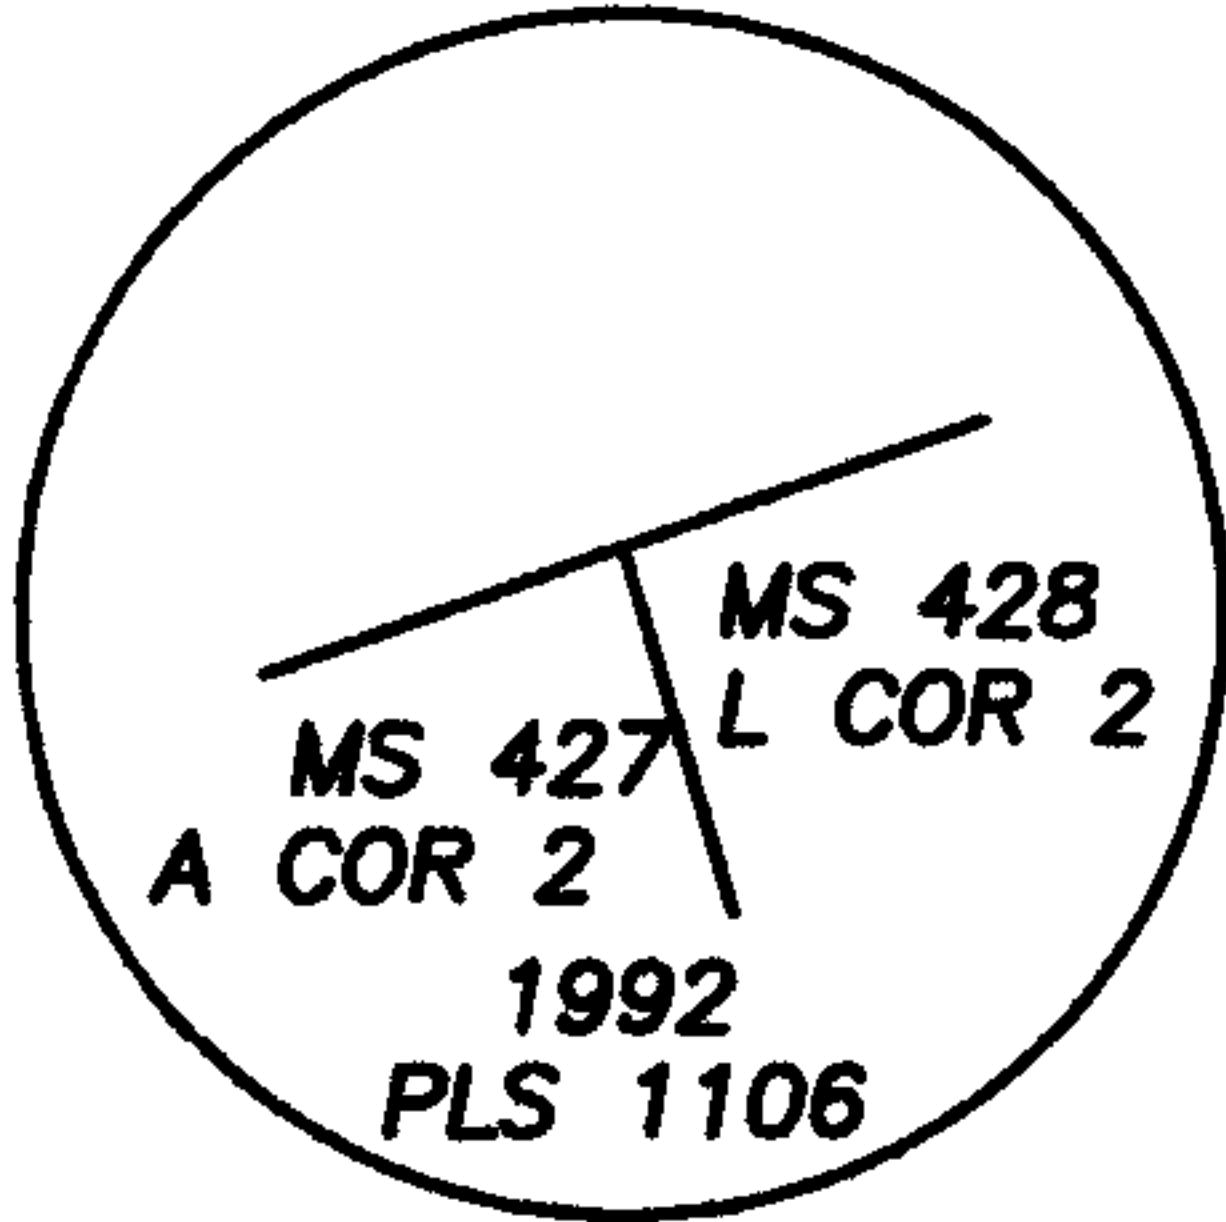

REGISTERED
PROFESSIONAL
LAND SURVEYOR

Kristina Powell

OREGON
MAY 9, 2017
KRISTINA POWELL
91201

EXPIRES 12-31-24

FILED January 3, 2024

BAKER COUNTY SURVEYOR

SURVEY NO. 8-36-99