

# RECORD OF LAND CORNER MONUMENTATION

SOUTHEAST CORNER SECTION 32, T. 8 S., R. 37 E., W.M.

30	29	29	28
31	32		32 33
31	32		32 33

**ORIGINALLY ESTABLISHED BY:** Lincoln E. Wilkes, U.S. Cadastral Engineer

**GROUP NUMBER:** 107

**APPROVAL DATE:** May 26, 1927

**SUBSEQUENT SURVEYS:** Corner maintenance activities performed October 10, 1984, by William L. Hanley, PLS #1639, as evidenced by the Certified Record of Land Corner Monumentation filed June 11, 1985, as Baker County Survey No. 8-37-11.

**ORIGINAL DESCRIPTION:** Set an iron post, 3 ft. long, 2 in. dia., 27 ins. in the ground, for cor. of secs. 32 and 33 only, with brass cap marked (diagram shown) from which  
 A white fir, 20 ins dia., bears N. 83° E., 63 lks. dist., marked T 8 S R 37 E S33 BT.  
 A white fir, 6 ins. dia., bears N. 56 1/2° W., 14 lks. dist., marked T 8 S R 37 E S 32 BT.

**HANLEY'S DESCRIPTION:** Brass cap found as per official record and marked as shown in diagram.  
 A fir snag, 20 ins. dia., bears N 83° E., 63 lks., with an open blaze and visible scribe.  
 A fir, 18 inch dia., bears N 50° W., 14 lks., with a healed blaze.  
 A newer fir, 6 ins. dia., bears N 40° E., 34 lks. and scribed X BT.

Improved surrounding rock mound around corner monument and set a 6 foot steel fence post alongside with a sign 54-9 attached.  
 New bearing tree:  
 A fir 12 ins. dia., bears N 42° E. 41.7 ft. marked T 8 S R 37 E S33 BT.

**EVIDENCE FOUND:** Found 2" iron pipe with 2 1/2" brass cap, marked as shown below, projecting 8" above ground, with a steel fence post with attached USFS 54-9 sign set South, 3 ft. from monument.

A white fir, 9" dbh, bears N.40°E., 22.4 ft., in good condition with healed double blazes (unrecorded, found by Hanley).  
 A white fir, 15" dbh, bears N.42°E., 41.7 ft., in good condition with healed double blazes (Hanley BT).  
 A white fir, 19" dbh, bears N.50°W., 9.2 ft., in good condition with healed single blaze (GLO BT).  
 No remaining evidence of the other GLO bearing tree was found.


**DESCRIPTION OF MONUMENTS AND ACCESSORIES SET AND METHODS USED:**

I accept the position of the found monument for the corner.

CORNER MONUMENT MARKED:

**From which, I SCRIBE A NEW BEARING TREE:**

- ▶ A white fir, 6" dbh, bears S.09°E., 16.22 ft. marked X in upper blaze, and BT in lower blaze.

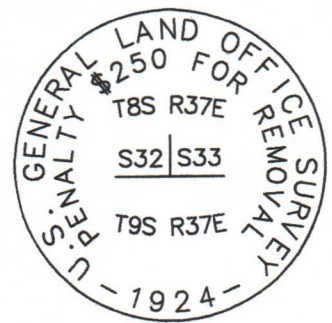

Painted a 6 inch red band around each bearing tree, painted the blazes red, and attached USFS 54-3 and 54-9 signs. Used a magnetic compass with 14° East declination to measure bearings to BT's. Used an EDM device to measure distance to new bearing tree, measuring to a 60d nail driven in the side-center-right at the root crown of the tree, with an attached 1 1/2" aluminum washer stamped PLS 69454. See associated Map of Survey dated October 17, 2023 for survey-related information.

**RESTORATION BY, STAMP AND DATE:**

Work Performed July 11, 2023  
 Survey completed October 17, 2023

Vincent L. Kelly, Survey Tech  
 Daniel B. Lee, Survey Tech

USDA FOREST SERVICE  
 NORTHEAST OREGON LAND ZONE  
 1550 Dewey Avenue, Suite A  
 Baker City, OR 97814  
 (541) 523-1283

FILED December 20, 2023  
 BAKER COUNTY SURVEYOR  
 SURVEY NO. 8-37-168  
9-37-343 A-9

