

CERTIFIED RECORD OF LAND CORNER MONUMENTATION

History of original corner establishment:

1 of 2

Corner established by John Hagel, U.S. Deputy Mineral Surveyor, under instructions received from the United States Surveyor General for Oregon dated Oct. 19, 1899, and designated as Survey No. 378.

T 8 S R 37 E
MS 378 AMD
9 TEL

Surveyor General records state:

Set a white fir post, 4 ins. square, 4 1/2 ft. long, 18 ins. in the ground, with a mound of earth and rocks around it, marked Tel. C. 9-378.

TELEPHONE
Cor. 9

A white fir tree, 10 ins. in diam., bears S44°10'E, 26.0 ft.

A white fir tree, 8 ins. in diam., bears S54°15'E, 25.0 ft.

Both blazed and marked Tel. C. 9-378 BT.

Corner was perpetuated by: John Hagel, U.S. Deputy Mineral Surveyor, under instructions dated Nov. 28, 1900, and designated as Survey No. 378 Amended.

Record states:

Identical with Cor. No. 9 of the original survey.

Corner was remonumented by: John R. Mitchell, an unlicensed Forester, as described by USFS Corner Card, dated 5-25-81.

Record states:

Found rotted post in md of earth & stone.

20" DF stump brs S44°E, 25' & 30" DF brs S54°E, 26' both w/HB.

Set 2 1/2" BC on 1"x32" gal pipe 24" deep in original hole in md of earth & stone marked TEL C9 MS 378 JRM 1981.

11" WF brs S12°E, 16' marked TEL 9 MS378 BT.

5" WF brs N66°W, 6' marked X BT.

Corner was visited by: Ken Lind, LS, for the Wallowa-Whitman National Forest in 2001.

Record states:

Amended Corner 9 was originally a post with two bearing trees. According to the notes of the unlicensed USFS surveyor, remnants of the post were found and replaced with the monument. No trace of the post was found, but the two bearing trees, both dead, are still there. Original scribing was found on both trees. The record distance, measured from the center of the bearing trees, fit the monument very well. The record bearings, determined by hand compass, also fit the monument very well. The position of the monument is acceptable in my opinion. Two new bearing trees were taken by the unlicensed USFS surveyor.

Corner was perpetuated by: Leland Myers, per Baker County Survey 8-37-135/9-37-279 in 2003. No Corner Record for this Monument was found. It is apparent Myers accepted the Mitchell brass cap and stamped his number and date over the top of Mitchell's.

Continued on page 2 of 2

REGISTERED
PROFESSIONAL
LAND SURVEYOR

Kristina Powell

OREGON
MAY 9, 2017
KRISTINA POWELL
91201

EXPIRES 12-31-24

FILED January 8, 2024
BAKER COUNTY SURVEYOR
SURVEY NO. 8-37-181

CERTIFIED RECORD OF LAND CORNER MONUMENTATION

Description of corner evidence found:

A 1 inch galv. iron pipe with a 2 1/2 inch brass cap, marked as shown. Firmly set 2 inches above ground, with rock collar.

From which:

A rotten fir stump (by Hagel) with dead & down remains, bears S54°15'E, 25.0 feet.

A broken off fir snag (by Hagel), bears S44°10'E, 26.0 feet.

A rotten fir snag (by Mitchell) dead and down, bears S12°E, 16.0 feet to stump hole.


A 13 inch white fir (by Myers), no blaze, bears N67°E, 12.0 feet to 1 1/2 inch SS washer mkd: PLS 699 in right side center, alive & healthy. *I scribe "9T 378 BT" in this tree this trip.

A 15 inch white fir (by Myers), no blaze, bears N66°W, 15.5 feet to a 1 1/2 inch SS washer mkd: PLS 699 in left side center, alive & healthy. *I scribe "9T 378 BT" in this tree this trip.

Monument falls West 225 feet from Fruit Creek Road; approximately 3,700 feet northerly of the intersection with NF-5540 Road.

T 8 S R 37 E
MS 378 AMD
9 TEL

TELEPHONE
Cor. 9

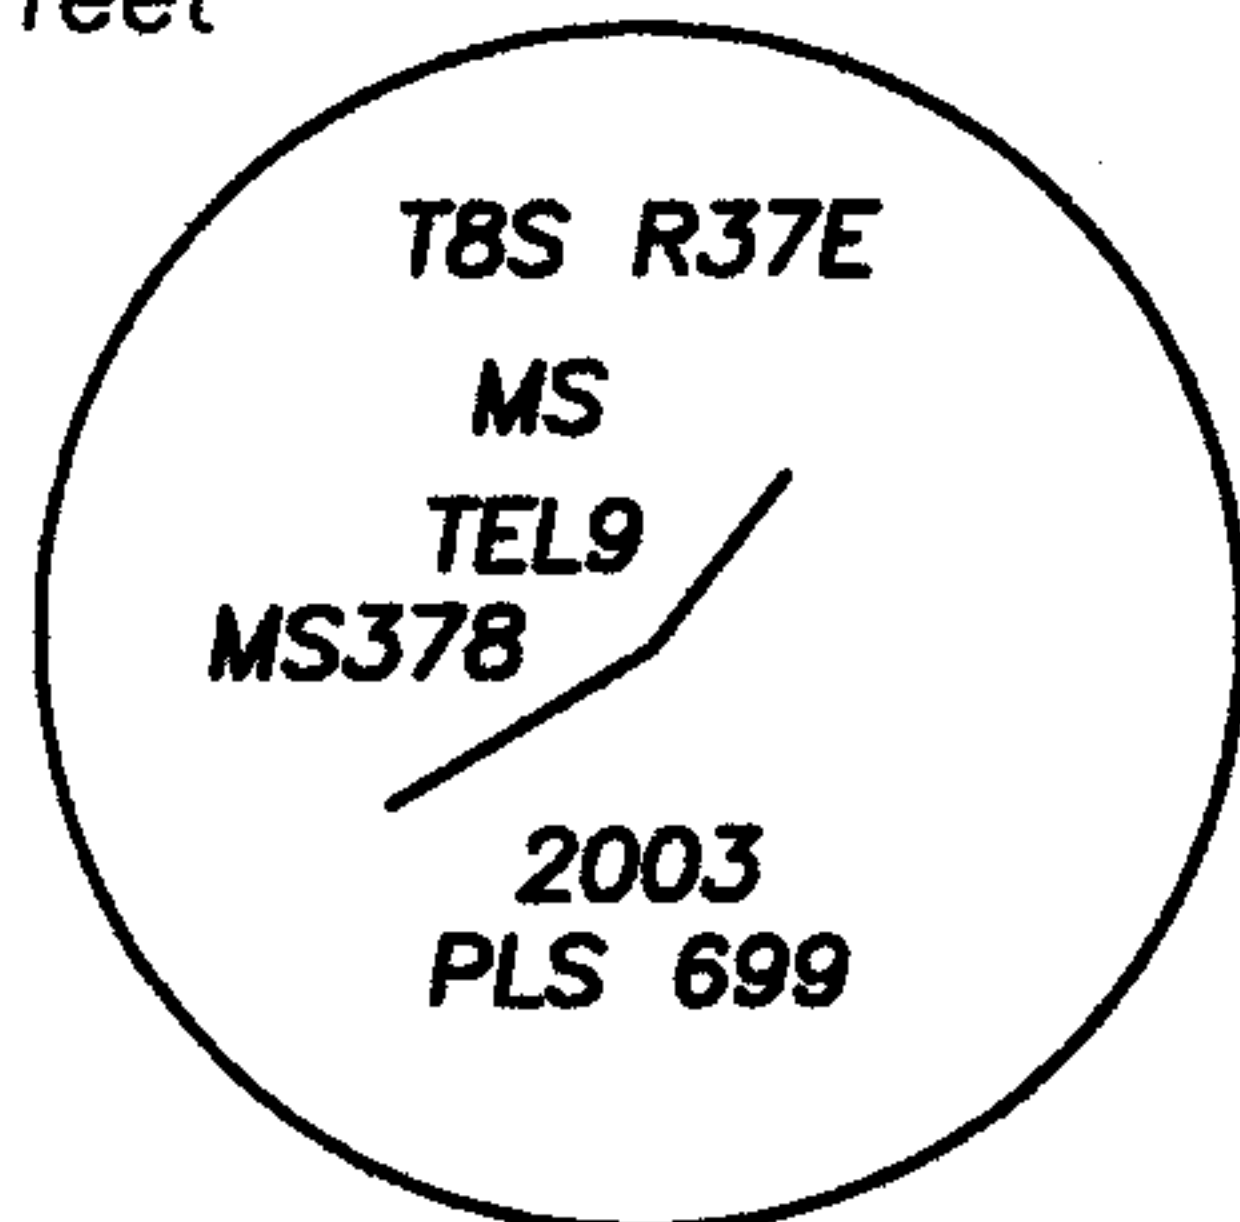

*2003 and PLS 699 were stamped over the top of the Mitchell stamping.

Description of monument and accessories I established to perpetuate original location of this corner:

*I scribe the Myers bearing trees as noted in the found notes.

Added Bearing Tree and Land Survey Monument signs as needed.

NAD 83 Geodetic Position

Lat. 44°49'10.5" N
Long. 118°12'40.6" W

Established by: Garmin ETREX 32x

I hereby certify that the corner is monumented and accessories taken as described using a steel tape and a Warren Knight staff compass, set with a declination of 14' East.

Witnesses: David Quittschreiber, Justin Seal

September 21, 2023

REGISTERED
PROFESSIONAL
LAND SURVEYOR

Kristina Powell

OREGON
MAY 9, 2017
KRISTINA POWELL
91201

EXPIRES 12-31-24

FILED January 8, 2024
BAKER COUNTY SURVEYOR
SURVEY NO. 8-37-187