


CERTIFIED RECORD OF LAND CORNER MONUMENTATION

History of original corner establishment:

Corner originally established by C.M. Foster, U.S. Deputy Mineral Surveyor under instructions dated December 7, 1899, for Mineral Survey No. 382A & B.

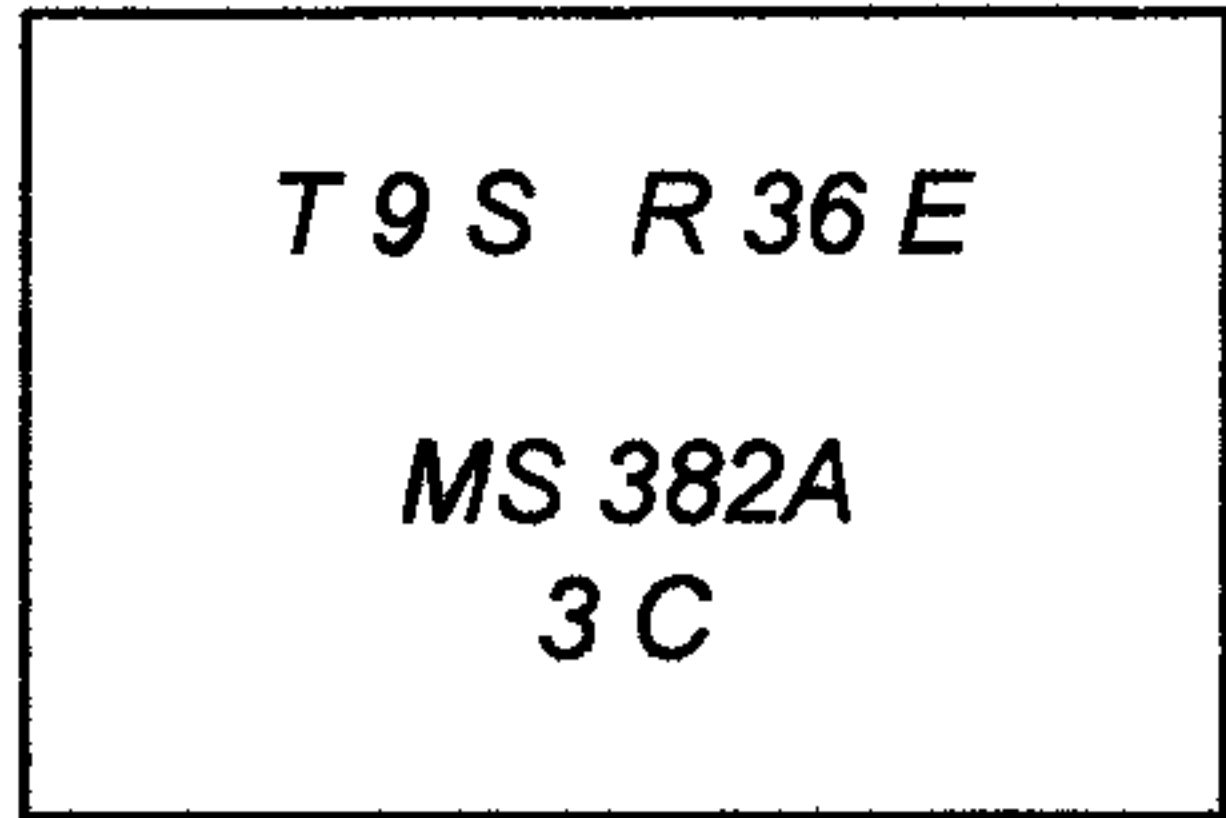

Record states:

To Cor. No. 3. A fir post 4 ft long 4 ins square, set 18 ins in the ground, scribed 3-382 A. Whence, A tamarack 18 ins dia bears N68°30'W, 12 ft dist, blazed and scribed 3-382, A.B.T. A tamarack 8 ins. dia bears S44°20'W, 5 ft dist, blazed and scribed 3-382, A.B.T.

Chapman
Cor. 3

Corner was remonumented by: William L. Hanley, per Corner Record 9-36-115, dated 5-2-88

No original evidence found.

At position determined by survey (see Record of Survey Plat filed separately for method of corner position reestablishment)...

Set 2" x 30" aluminum pipe with 2 1/2" dia aluminum cap attached 25" in ground surrounded with a mound of earth & stone and placed 6' steel fence post alongside with signs 54-9 & 54-2 attached. Aluminum cap marked as shown to the right...

New bearing trees established:

A lodgepole pine 9" dia brs S39°E, 6.5' dist mkd C-3-382A BT.
A lodgepole pine 9" dia brs N80°W, 2.2' dist mkd C-3-382A BT.


Each new bearing tree has signs 54-3 & 54-9 attached below a surrounding 6" band of red paints and has a brass washer marked PLS 1639 nailed flush to red painted blaze.

Compass declination 20° East.

I hereby certify that the above described corner was reestablished and monumented to U.S.F.S. standards by me and witnessed by Bill Gohring on December 17, 1987.

Description of corner evidence found:

A 2 inch aluminum pipe with a 2 1/2 inch aluminum cap, marked as shown. Firmly set 8 inches above ground.

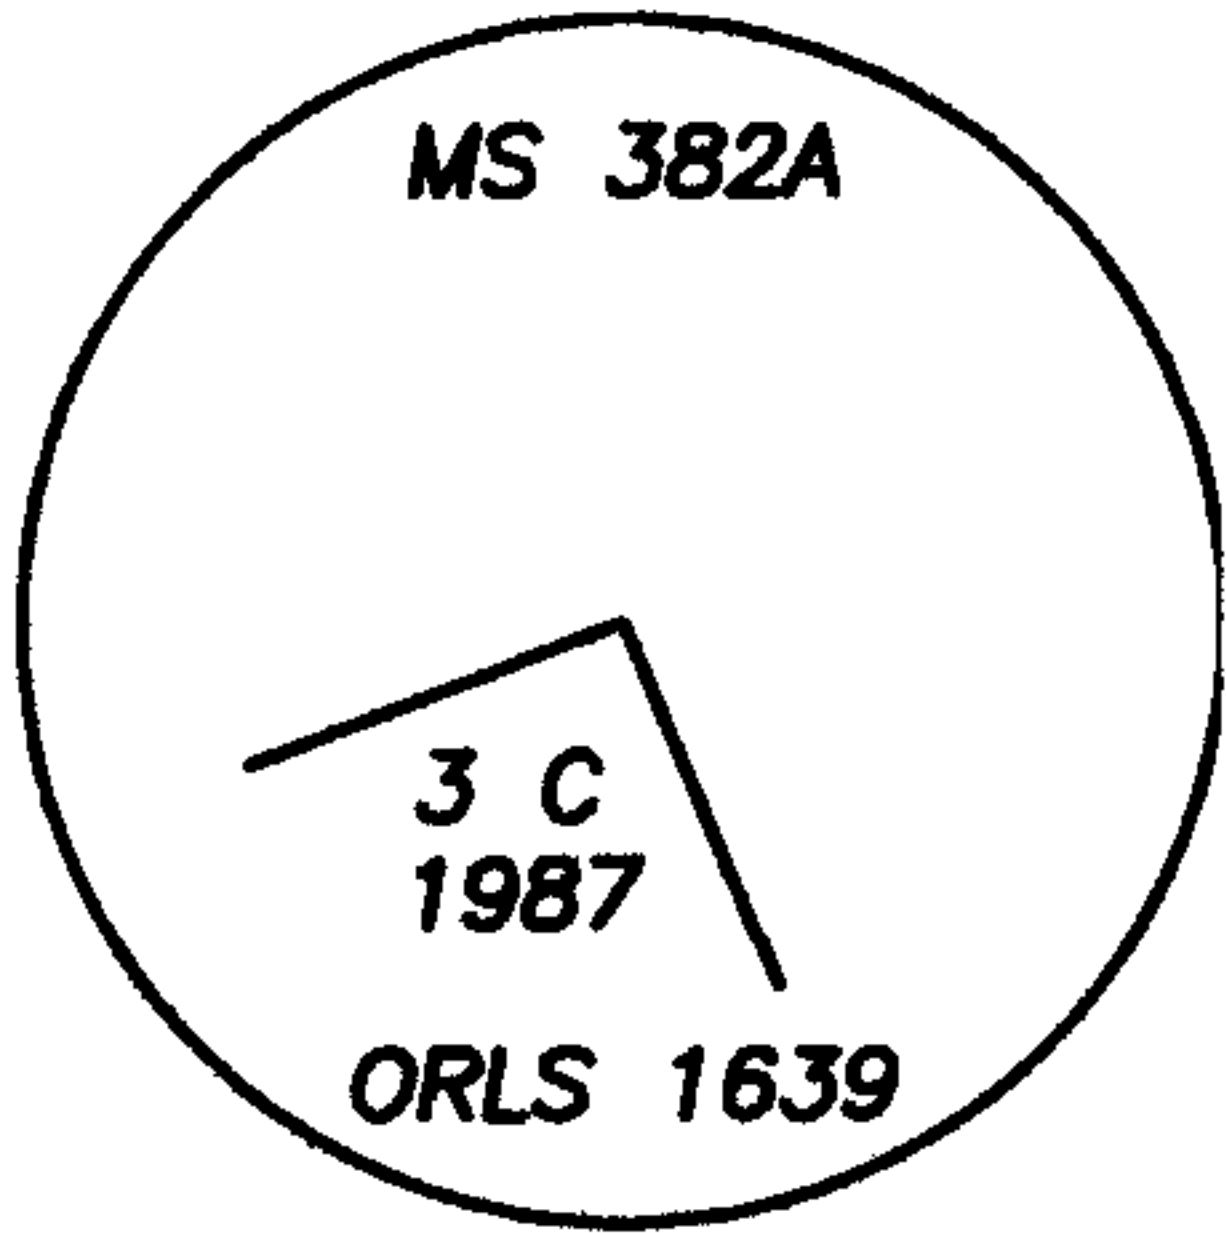

From which:

A 10 inch lodgepole pine snag (by Hanley) with partially healed blaze and scribe "C3 382A BT" visible, bears S39°E, 6.5 feet.

An 11 inch lodgepole pine (by Hanley) with partially healed blaze and scribe "C3 382A BT" visible, bears N80°W, 2.2 feet, alive and healthy.

A steel T-post bears S84°W, 5.0 feet; with sign: Property Boundary

A steel T-post bears S20 1/2°E, 5.0 feet; with two (2) signs: Property Boundary, Land Survey Monument.

Description of monument and accessories I established to perpetuate original location of this corner:

New Bearing Tree:

An 8 inch lodgepole pine scribed "3C 382A BT", bears N41°E, 39.5 feet; measured to a 3/4 inch brass washer mkd: "LS 91201", at the right side of tree center.

Added Bearing Tree and Land Survey Monument signs as needed.

Monument falls North 500 feet of a gravel driveway, that stems off of the 030 Road.

NAD 83 Geodetic Position

Lat. 44°48'43.8" N
Long. 118°14'22.0" W

Established by: Garmin ETREX 32x

I hereby certify that the corner is monumented and accessories taken as described using a steel tape and a Warren Knight staff compass, set with a declination of 14° East.

Witnesses: David Quittschreiber, Justin Seal; September 20, 2023

REGISTERED
PROFESSIONAL
LAND SURVEYOR

K.P. Powell

OREGON
MAY 9, 2017
KRISTINA POWELL
91201

EXPIRES 12-31-24

FILED January 3, 2024
BAKER COUNTY SURVEYOR
SURVEY NO. 9-36-139