

CERTIFIED RECORD OF LAND CORNER MONUMENTATION

History of original corner establishment:

Corner originally established by C.M. Foster, U.S. Deputy Mineral Surveyor under instructions dated December 7, 1899, for Mineral Survey No. 382A & B.

Record states:

To Cor. No. 4. A pine post 4 ft long 4 ins square, set 18 ins. in the ground scribed 4-382-A. whence, A pine 6 ins dia bears N73°W, 15.5 ft dist blazed and scribed 4-382-A B.T.

T 9 S R 36 E
MS 382A
4 A / 4 C

Annululu Cor. 4
Chapman Cor. 4

Corner was remonumented by: William L. Hanley per Corner Record 9-36-116, dated 5-2-88.

At position determined by survey (see Record of Survey Plat filed separately for method of corner position reestablishment)...

Set 2" x 30" aluminum pipe with a 2 1/2" dia aluminum cap attached 25" in ground surrounded with a mound of earth & stone and placed 6' steel fence post alongside with signs 54-9 attached.

Aluminum cap marked as shown to the right...

New bearing trees established:

A western larch 7" dia brs S83°W, 28.5' dist mkd A-4-C-4-382A BT.

A lodgepole pine 7" dia brs N33°E, 4.7' dist mkd A-4-C-4-382A BT.

Each new bearing tree has signs 54-3 & 54-9 attached below a surrounding 6" band of red paint and has a brass washer marked PLS 1639 nailed flush to red painted blaze.

Compass declination 20° East.

I hereby certify that the above described corner was reestablished and monumented to USFS standards by me and witnessed by Bill Gohring on December 17, 1987.

REGISTERED
PROFESSIONAL
LAND SURVEYOR

K.P. Powell

OREGON
MAY 9, 2017
KRISTINA POWELL
91201

EXPIRES 12-31-24

Continued on page 2 of 2

FILED January 3, 2024
BAKER COUNTY SURVEYOR
SURVEY NO. 9-36-140

CERTIFIED RECORD OF LAND CORNER MONUMENTATION

Description of corner evidence found:

A 2 inch aluminum pipe with a 2 1/2 inch aluminum pipe, marked as shown. Firmly set 6 inches above ground, with a rock collar.

From which:

A 9 inch lodgepole pine snag (by Hanley) with partially healed blaze and visible scribe "A4C4 382A BT", bears N33°E, 4.7 feet.

An 11 inch western larch (by Hanley) with healed blaze, bears S83°W, 28.5 feet, alive and healthy.

A steel T-post bears S72 1/2°W, 42.0 feet; with sign: Property Boundary

A steel T-post bears N84°E, 5.0 feet; with two (2) signs: Property Boundary, Land Survey Monument.

Monument falls North 510 feet of a gravel driveway, that stems off of the 030 Road.

Description of monument and accessories I established to perpetuate original location of this corner:

New Bearing Tree:

A 14 inch tamarack scribed "4A - 4C 382A BT" bears N77°E, 32.9 feet; measured to a 3/4 inch brass washer mkd: "LS 91201", at the right side of tree center.

Added Bearing Tree and Land Survey Monument signs as needed.

NAD 83 Geodetic Position

Lat. 44°48'43.6" N
Long. 118°14'24.2" W

Established by: Garmin ETREX 32x


I hereby certify that the corner is monumented and accessories taken as described using a steel tape and a Warren Knight staff compass, set with a declination of 14° East.

Witnesses: David Quittschreiber, Justin Seal

September 20, 2023

T 9 S R 36 E
MS 382A
4 A / 4 C

Annululu Cor. 4
Chapman Cor. 4

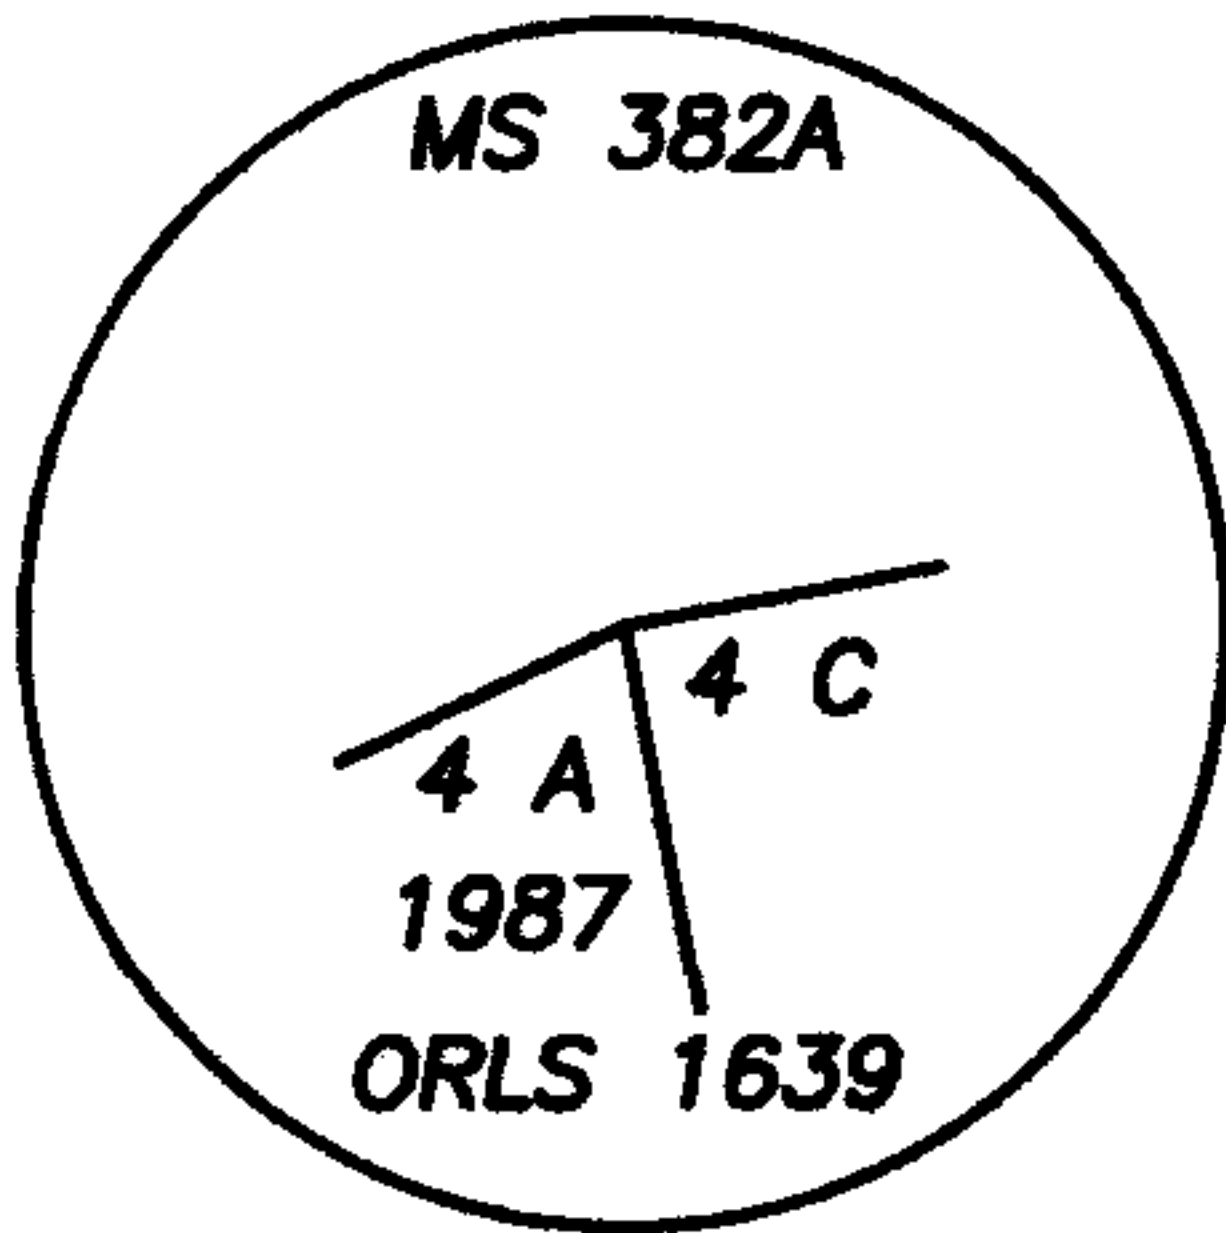

REGISTERED
PROFESSIONAL
LAND SURVEYOR

Kristina Powell

OREGON
MAY 9, 2017
KRISTINA POWELL
91201

EXPIRES 12-31-24

FILED January 3, 2024
BAKER COUNTY SURVEYOR
SURVEY NO. 9-36-140