

**CERTIFIED RECORD OF LAND CORNER MONUMENTATION**

**History of original corner establishment:**

Corner established by Emil R. Voight, U.S. Deputy Mineral Surveyor, under instructions received from the from the United States Surveyor for Oregon, dated July 27, 1892, and designated as Survey No. 257.

Surveyor General records state:

Set a post 4 1/2 ft long 4 ins square 12 ins in ground with mound of stone marked Cor No 8 LCPC MS No. 257.  
A tamarack 18 ins dia bears N81°E 0.35 chs dist, a pine 28 ins dia bears S04°E 0.53 chs dist, both blazed and marked Cor No 8 LCPC MS 257 BT.

**Corner position remonumented by:** John R. Mitchell in 1980 ... Set a 2 1/2 ins brass cap on a 32" x 1" galv pipe in rock mound marked LCPC 8 MS 257.  
A douglas fir 10 ins dia bears N67°E 6 ft, a white fir 9 ins dia bears S32°E 5 ft dist, both marked LCPC MS 257 BT.

**Corner was remonumented by:** William L. Hanley, per Corner Record 9-37-119; dated March 14, 1986.

Found monument set by John R. Mitchell.

A tamarack 24 ins dia bears N81°E 35 lks with scribes visible.  
A ponderosa pine 32 ins dia bears S04°E 53 lks with scribes visible on stump.  
Trees found set by John R. Mitchell:  
A douglas fir 10 ins dia bears N67°E 6 ft.  
A white fir 9 ins dia bears S32°E 5 ft.

Set a 2 1/2" aluminum cap on 2" aluminum pipe 30 ins long 25 ins in ground with 5 ins proj. out of ground with surrounding rock mound and 6 ft steel fence post alongside with sign 54-9 attached. Buried monument alongside north.

Aluminum cap marked as shown in corner diagram.

Each original bearing tree has signs 54-3 and 54-9 attached below a 6 inch band of red paint.

I hereby certify that the above described corner monument was properly established by me and witnessed by Jim DeMastus and Daryl Schuchardt on May 7, 1985.

Continued on page 2 of 2

T 9 S R 37 E  
MS 257  
8 LCPC

Louise Consolidated  
Placer Claim  
Cor. 8

REGISTERED  
PROFESSIONAL  
LAND SURVEYOR

*Kristina Powell*

OREGON  
MAY 9, 2017  
KRISTINA POWELL  
91201

EXPIRES 12-31-24

FILED January 3, 2024  
BAKER COUNTY SURVEYOR  
SURVEY NO. 9-37-358

**CERTIFIED RECORD OF LAND CORNER MONUMENTATION**

**Description of corner evidence found:**

A 2 inch aluminum pipe with a 2 1/2 inch aluminum cap, marked as shown. Firmly set flush with ground, with rock collar.

From which:

A rotten 24 inch Tamarack stump (by Voight) bears N81°E, 35 links to stump hole.


A 32 inch pine stump (by Voight) with scribe marks, bears S4°E, 53 links.

A 14 inch fir snag (by Mitchell) with healed blaze, bears N32°E, 5.0 feet.


A 12 inch Douglas Fir (by Mitchell) with healed blaze, bears N67°E, 6.0 feet, alive and healthy.

A steel T-post bears S17°W, 5.0 feet; with two (2) signs: Property Boundary, Land Survey Monument.

Monument falls West 750 feet from Cracker Creek Road

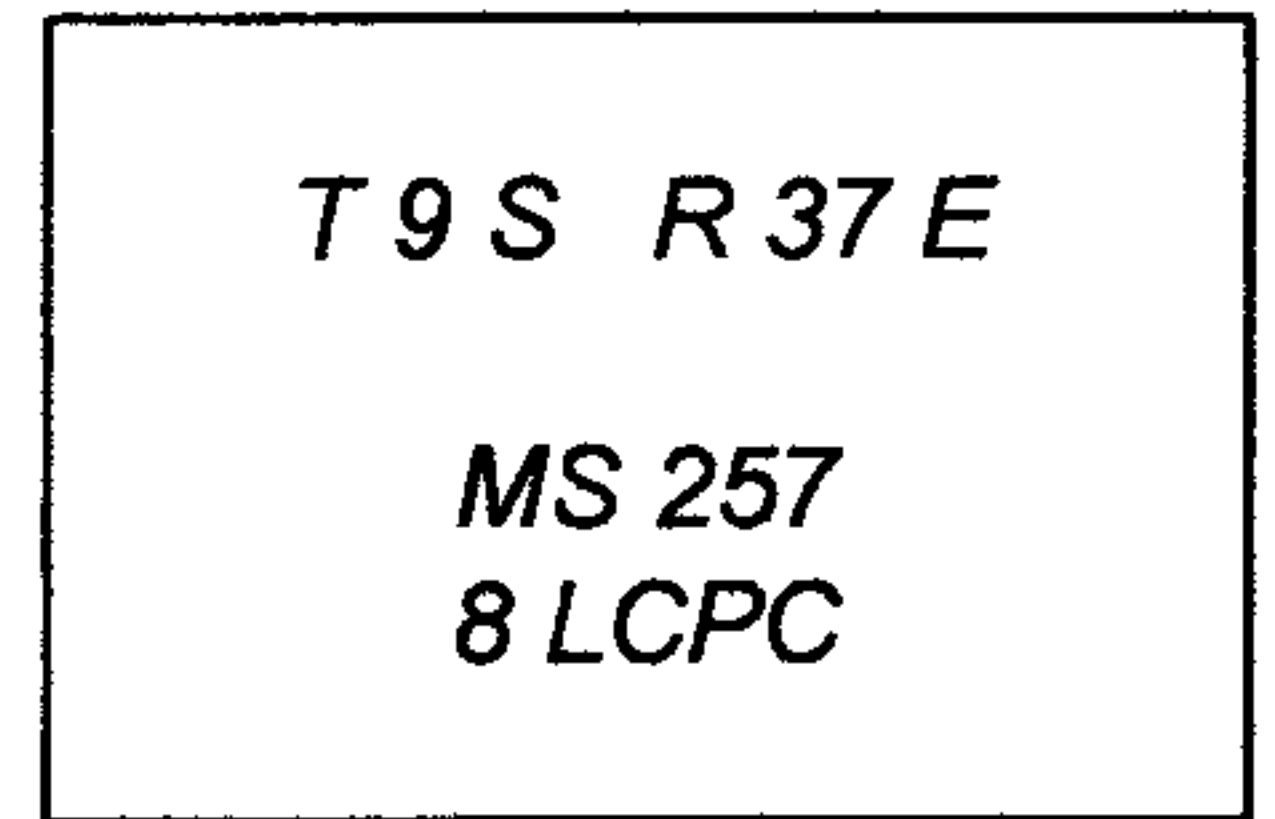

Louise Consolidated  
Placer Claim  
Cor. 8

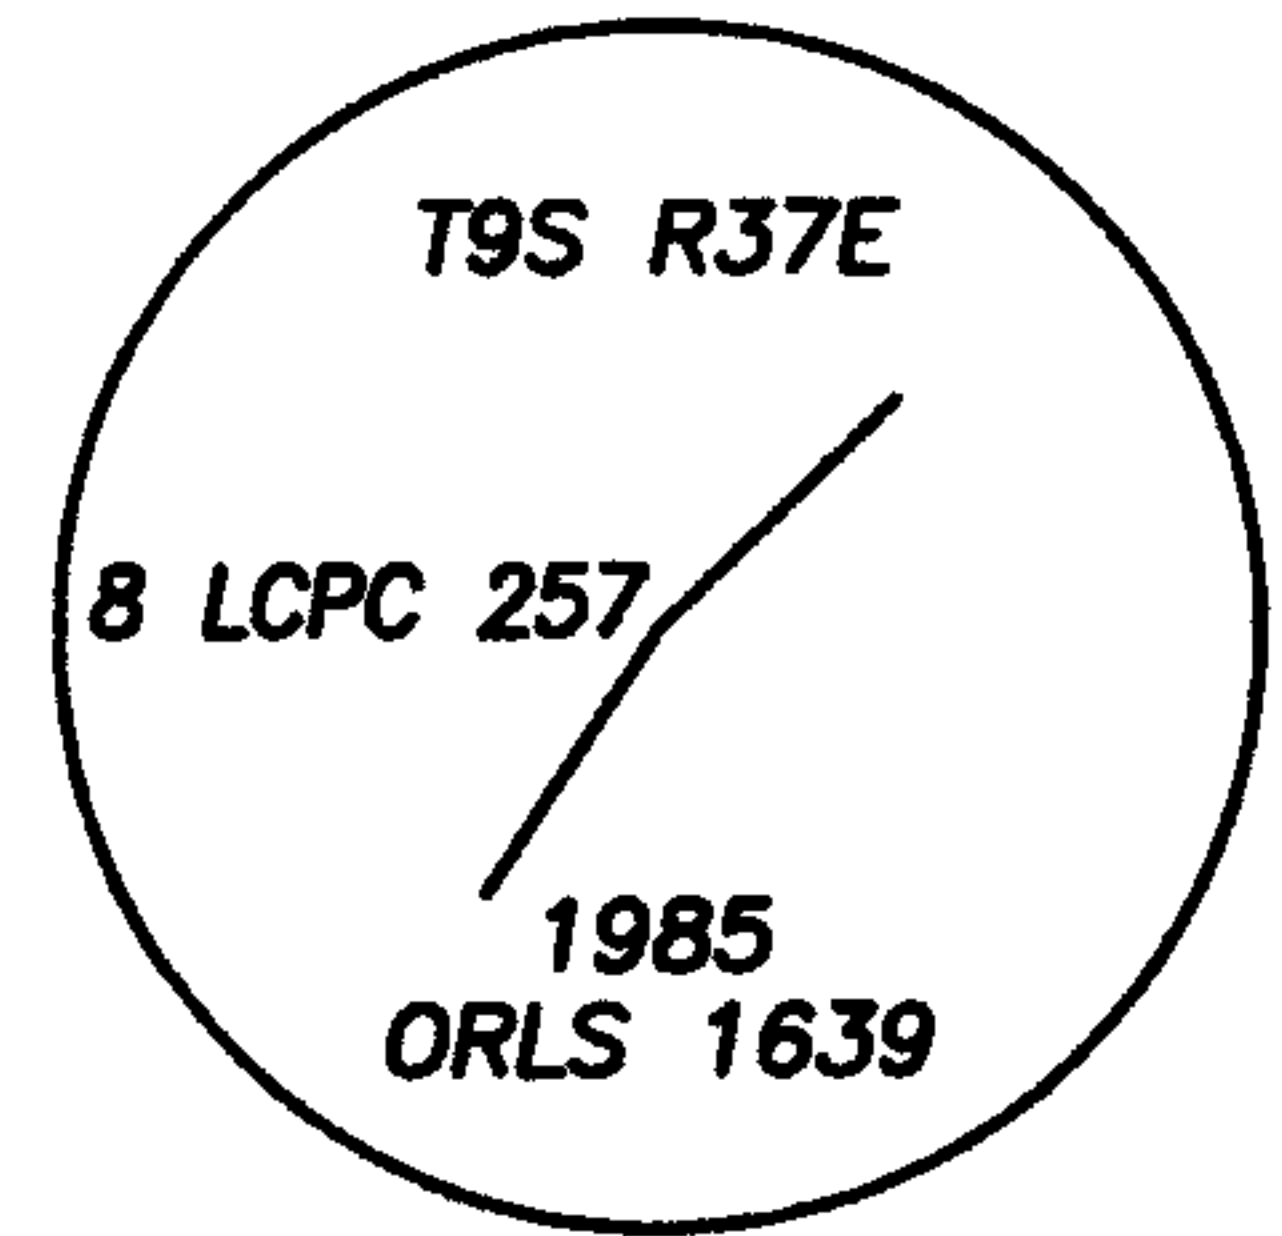

**Description of monument and accessories I established to perpetuate original location of this corner:**

New Bearing Tree:

A 5 inch White Fir, with double blaze scribed "X BT" bears N58°W, 32.1 feet; measured to a 3/4 inch brass washer mkd: "LS 91201", at the right side of tree center.

Set a steel T-post bears N37°E, 5.0 feet; with sign: Property Boundary

Added Bearing Tree and Land Survey Monument signs as needed.

NAD 83 Geodetic Position

Lat. 44°48'58.0" N  
Long. 118°12'30.9" W

Established by: Garmin ETREX 32x

I hereby certify that the corner is monumented and accessories taken as described using a steel tape and a Warren Knight staff compass, set with a declination of 14' East.

Witnesses: David Quittschreiber, Justin Seal, Shar Hutchison

August 16, 2023

REGISTERED  
PROFESSIONAL  
LAND SURVEYOR

*Kristina Powell*

OREGON  
MAY 9, 2017  
KRISTINA POWELL  
91201

EXPIRES 12-31-24

FILED January 3, 2024  
BAKER COUNTY SURVEYOR  
SURVEY NO. 9-37-358