

CERTIFIED RECORD OF LAND CORNER MONUMENTATION

History of original corner establishment:

Corner was established by: William L. Hanley, per Corner Record 9-37-133, dated March 14, 1986.

Set a 2 1/2" aluminum cap on 2" aluminum pipe, 30 ins. long, 25 ins. in the ground with 5 ins. proj. out of ground with surrounding rock mound and 6 ft. steel fence post alongside with sign 54-9 attached.

Aluminum cap marked as shown in corner diagram.

New bearing trees established:

A fir 6 ins. diam. bears S35 1/2°W, 46.0 ft. dist.

A fir 7 ins. diam. bears N47°E, 34.6 ft. dist., both trees marked 1 2 HPS 410/S 32 BT.

Each new bearing tree has signs 54-3 and 54-9 attached below a 6 inch band of red paint and has a brass washer marked PLS 1639 nailed flush with BT blaze.

I hereby certify that the above described corner monument was properly maintained to USFS standards under my supervision and witnessed by Jim DeMastus on May 17, 1985.

Description of corner evidence found:

A 2 inch aluminum pipe with a 2 1/2 inch aluminum cap, marked as shown. Firmly set 4 ins. above ground with rock collar.

From which:

A fir snag (by Hanley) with visible scribe marks, dead and down, bears N47°E, 34.6 feet to stump hole.

A 12 inch Douglas fir (by Hanley) with healed blaze, bears S35 1/2°W, 46.0 feet, alive and healthy.

A 14 inch white fir (by Hatfield) scribed X BT on double blaze, bears S47°E, 45.4 feet to a 1 1/2 inch SS washer mkd: LS 69454 in right side center, alive and healthy. BT tag dated 7/11/23.

A steel T-post bears S37 1/2°W, 5 feet with Property Boundary and Land Survey Monument signs.

Monument falls East 950 feet of Cracker Creek Road.

Description of monument and accessories I established to perpetuate original location of this corner:

No perpetuation necessary. Hatfield perpetuated this corner on 7/11/23.

NAD 83 Geodetic Position

Lat. 44°49'04.5" N
Long. 118°11'59.5" W

Established by: Garmin ETREX 32x


I hereby certify that the corner is monumented and accessories taken as described using a steel tape and a Warren Knight staff compass, set with a declination of 14° East.

Witnesses: David Quittschreiber, Justin Seal, Shar Hutchison

August 17, 2023

T 9 S R 37 E
MS 410
INT PT W/ SEC LINE

INTERSECTION POINT
WITH NORTH LINE OF
T9S, R37E

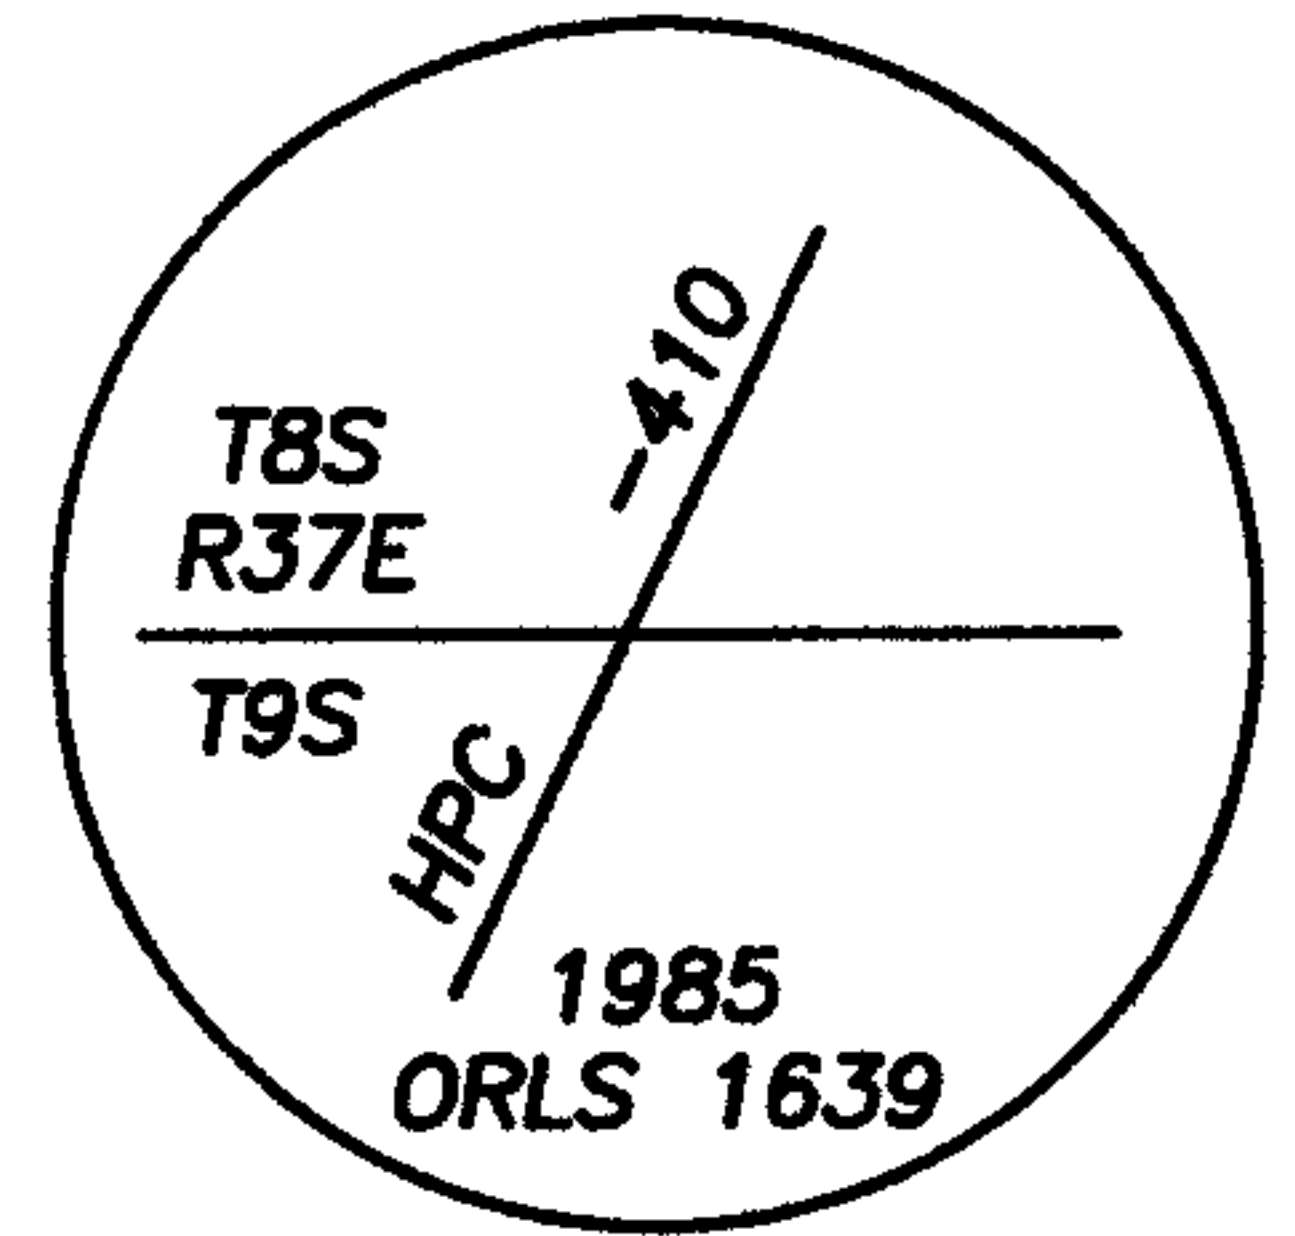

REGISTERED
PROFESSIONAL
LAND SURVEYOR

Kristina Powell

OREGON
MAY 9, 2017
KRISTINA POWELL
91201

EXPIRES 12-31-24

FILED January 3, 2024

BAKER COUNTY SURVEYOR
SURVEY NO. 9-37-360