

CERTIFIED RECORD OF LAND CORNER MONUMENTATION

History of original corner establishment:

Corner established by Arthur Philbrick, U.S. Deputy Mineral Surveyor, under instructions received from the United States Surveyor General for Oregon, dated Nov. 04, 1901, and designated as Survey No 452.

T 9 S R 37 E
MS 452
2 BB

Surveyor General records state:

A fir post 4 1/2 ft long 4 ins square set 2 ft in ground with mound of earth, scribed BB 2-452 on N W face whence A tamarack 12 ins dia bears S31°30'W 19.5 ft and a tamarack 18 ins dia bears N38°45'W 91 ft each blazed and scribed BT BB 2-452.

**Black Belle
Quartz Claim
Cor. 2**

Corner was remonumented by: William L. Hanley, per Corner Record 9-37-109; dated March 14, 1986.

Found a 14 in long section 5 1/2" x 5 1/2" square post with fragmentary scribe marks.

A dead tamarack 12 ins dia with full scribes, brs S31°30'W 19.5 ft.

A green ponderosa pine 18 ins dia with healed blaze, brs N38°45'W 91 ft.

Set a 2 1/2 in aluminum cap on a 2 in aluminum pipe 30 ins long and buried 25 ins in the ground with 5 ins projecting out of the ground with a surrounding rock mound and a 6 ft steel fence post alongside with a sign 54-9 attached.

Buried remains of original post.

Aluminum cap marked as shown in corner diagram.

New bearing tree established:

A lodgepole pine 6 ins dia bears N33°30'E 11.2 ft marked BB2-452 BT.

Each new bearing tree has a brass washer marked PLS 1639 nailed flush with BT blaze and has signs 54-3 and 54-9 attached below a 6 inch band of red paint.

I hereby certify that the above described corner monument was properly established by me and witnessed by Jim DeMastus on April 23, 1985.

Continued on page 2 of 2

REGISTERED
PROFESSIONAL
LAND SURVEYOR

K.P.

OREGON
MAY 9, 2017
KRISTINA POWELL
91201

EXPIRES 12-31-24

FILED January 3, 2024
BAKER COUNTY SURVEYOR
SURVEY NO. 9-37-361

CERTIFIED RECORD OF LAND CORNER MONUMENTATION

Description of corner evidence found:

A 2 inch aluminum pipe with a 2 1/2 inch aluminum cap, marked as shown. Firmly set 6 inches above ground, with a rock collar.

From which:

A 9 inch lodgepole pine (by Hanley) with partially healed blaze scribed "BB2 452 BT", bears N33°30'E, 11.2 feet, alive and healthy.

A 12 inch tamarack snag (by Philbrick) with open blaze and visible scribing "BB2-452", dead and down, bears S30°30'W, 19.5 feet to stump hole.

A 22 inch ponderosa pine snag (by Philbrick) with healed blaze, bears N38°45'W, 91.0 feet.

A steel T-post bears S4 1/2°E, 5.0 feet; with two (2) signs: Property Boundary, Land Survey Monument.

A steel T-post bears N14 1/2°W, 35.0 feet; with sign: Property Boundary.

Monument falls East 0.25 miles from a 10-foot wide gravel road.

Description of monument and accessories I established to perpetuate original location of this corner:

New Bearing Tree:

A 6 inch lodgepole pine scribed "X BT" on single blaze, bears S68°E, 55.5 feet, measured to a 3/4 inch brass washer mkd: "LS 91201", at the right side of tree center.

Added Bearing Tree and Land Survey Monument signs as needed.

NAD 83 Geodetic Position


Lat. 44°47'46.6" N
Long. 118°12'14.9" W

Established by: Garmin ETREX 32x


I hereby certify that the corner is monumented and accessories taken as described using a steel tape and a Warren Knight staff compass, set with a declination of 14' East.

Witnesses: David Quittschreiber, Justin Seal

September 7, 2023

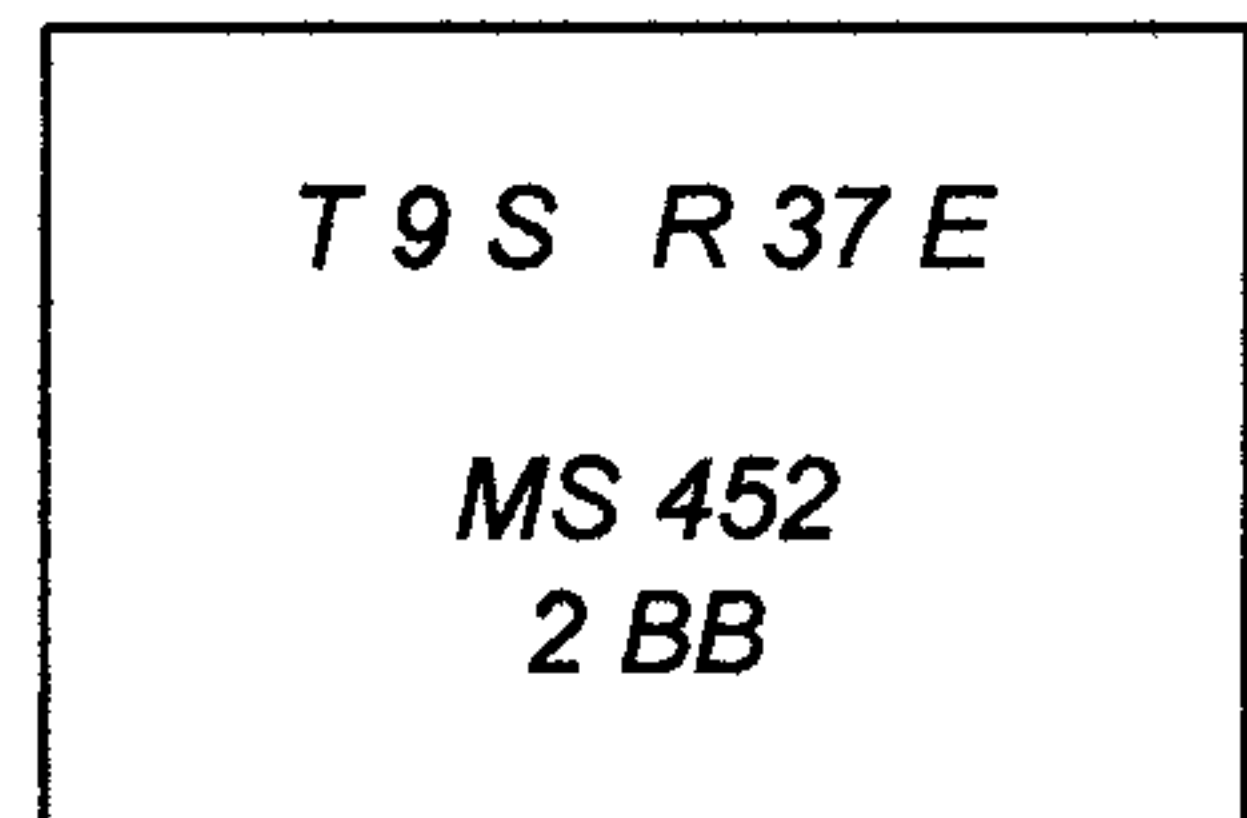

Black Belle
Quartz Claim
Cor. 2

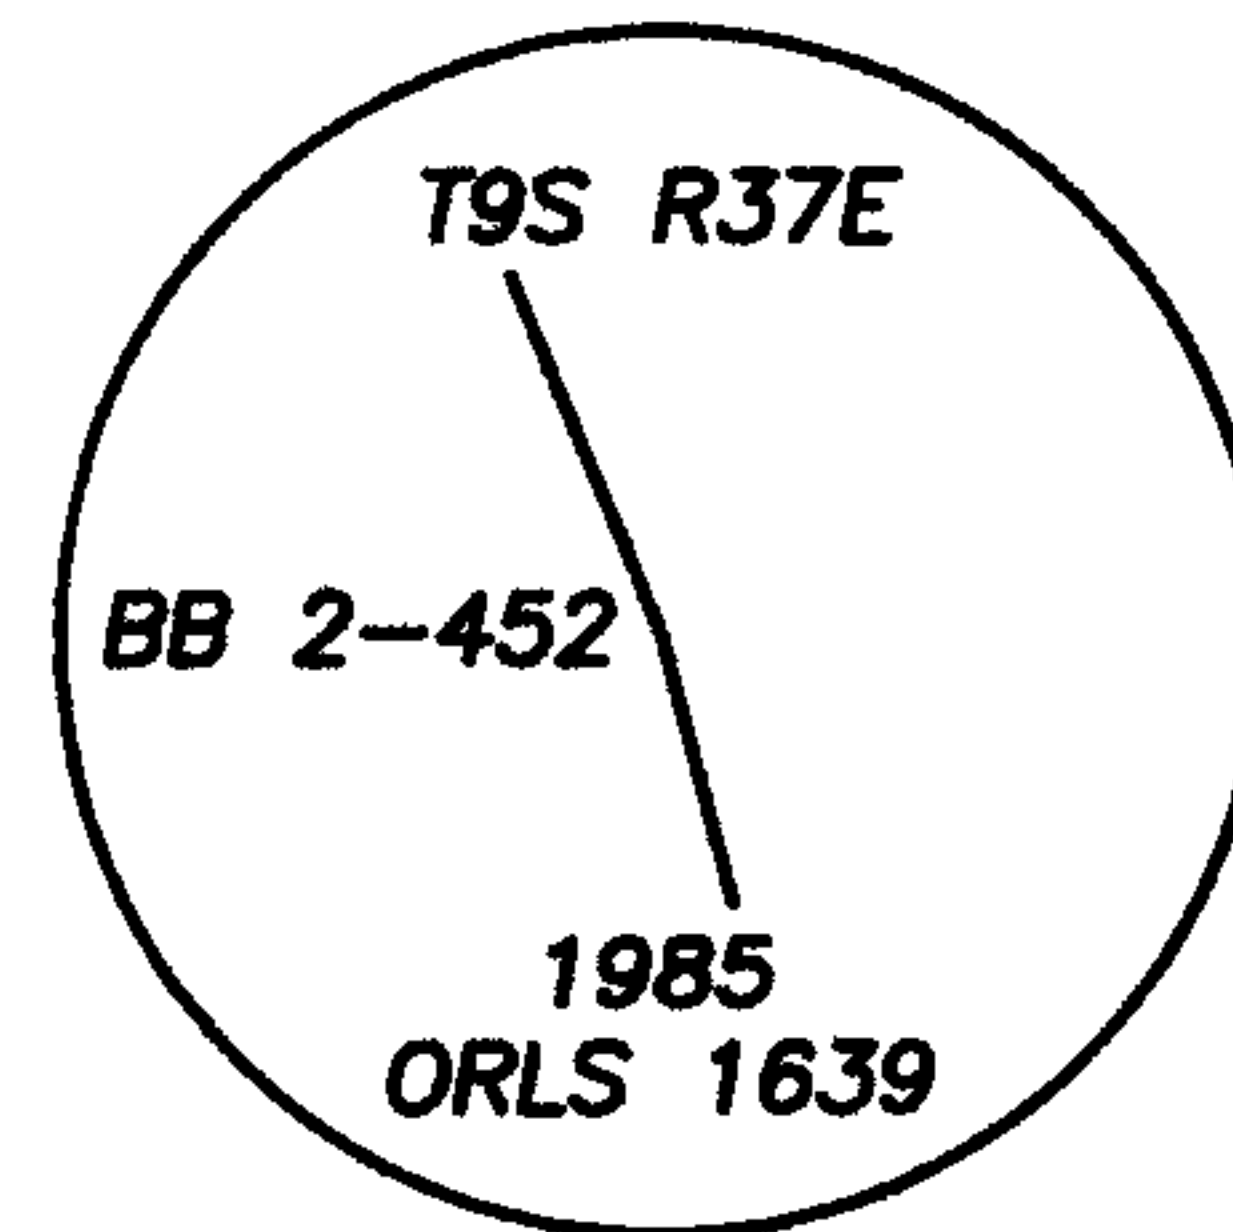

FILED January 3, 2024
BAKER COUNTY SURVEYOR
SURVEY NO. 9-37-361

REGISTERED
PROFESSIONAL
LAND SURVEYOR

Kristina Powell

OREGON
MAY 9, 2017
KRISTINA POWELL
91201

EXPIRES 12-31-24