

CERTIFIED RECORD OF LAND CORNER MONUMENTATION

History of original corner establishment:

Corner established by Arthur Philbrick, U.S. Deputy Mineral Surveyor, under instructions received from the United States Surveyor General for Oregon, dated Nov. 04, 1901 and designated as Survey No 452.

T 9 S R 37 E
MS 452
6 BB

Surveyor General record state:

A pine post 4 1/2 ft long 4 ins square set 2 ft in the ground with mound of earth, scribed BB 6-452 on NE face whence a tamarack 20 ins in dia bears S87°30'W 19.1 ft and a red fir 24 ins in diam bears S9°30'E 7 ft each blazed and scribed BT BB 6-452

**Black Belle
Quartz Claim
Cor. 6**

Corner was remonumented by: William L. Hanley, per Corner Record 9-37-113; dated March 14, 1986

Found location post a 10 in dia dead tree blazed on four sides

A green fir 34 ins dia marked "6-452" visible in a partially healed blaze, brs S9°30'E 7 ft.
A down tamarack 16 ins dia with full scribes visible, brs S87°30'W 19.1 ft dist.

Set 2 1/2 in aluminum cap on 2 in aluminum pipe 30 ins long 25 ins in ground with 5 ins proj. out of ground with rock mound and 6 ft steel fence post alongside with sign 54-9 attached. Buried remains of original post alongside.

Aluminum cap marked as shown in corner diagram.

New bearing tree established:

A fir 16 ins dia bears N80°30'E 42.5 ft marked BB6-452 BT.

Each original bearing tree and each new bearing tree has signs 54-3 and 54-9 attached below a 6 in band of red paint, additionally each new bearing tree has a brass washer marked PLS 1639 nailed flush with BT blaze.

I hereby certify that the above described corner monument was properly established by me and witnessed by Jim DeMastus on April 23, 1985.

Continued on page 2 of 2

REGISTERED
PROFESSIONAL
LAND SURVEYOR

Kristina Powell

OREGON
MAY 9, 2017
KRISTINA POWELL
91201

EXPIRES 12-31-24

FILED January 3, 2024
BAKER COUNTY SURVEYOR
SURVEY NO. 9-37-364

CERTIFIED RECORD OF LAND CORNER MONUMENTATION

Description of corner evidence found:

A 2 inch aluminum pipe with a 2 1/2 inch aluminum cap, marked as shown.

From which:

A 34 inch high fir stump (by Philbrick) with open blaze and visible scribing, bears S9 1/2°E, 7.0 feet.

Rotten tamarack remains (by Philbrick) bear S87 1/2°W, 19.1 feet.

A 22 inch fir snag (by Hanley) with partially healed blaze and visible scribing, bears N 80 1/2°E, 42.5 feet.

A steel T-post bears N19°W, 5.0 feet; with two (2) signs: Property Boundary, Land Survey Monument.

A steel T-post bears N62°E, 35.0 feet; with sign: Property Boundary.

Monument falls West 700 feet of a 10-foot wide gravel road.

Description of monument and accessories I established to perpetuate original location of this corner:

New Bearing Trees:

An 8 inch lodgepole pine scribed "6 BB 452 BT" bears East, 23.7 feet; measured to a 3/4 inch brass washer mkd: "LS 91201", at the right side of tree center.

An 8 inch ponderosa pine scribed "X BT" on single blaze, bears S5°W, 63.3 feet; measured to a 3/4 inch brass washer mkd: "LS 91201", at the right side of tree center.

Added Bearing Tree and Land Survey Monument signs as needed.

NAD 83 Geodetic Position


Lat. 44°47'38.5" N
Long. 118°12'29.8" W

Established by: Garmin ETREX 32x


I hereby certify that the corner is monumented and accessories taken as described using a steel tape and a Warren Knight staff compass, set with a declination of 14° East.

Witnesses: David Quittschreiber, Justin Seal

September 7, 2023

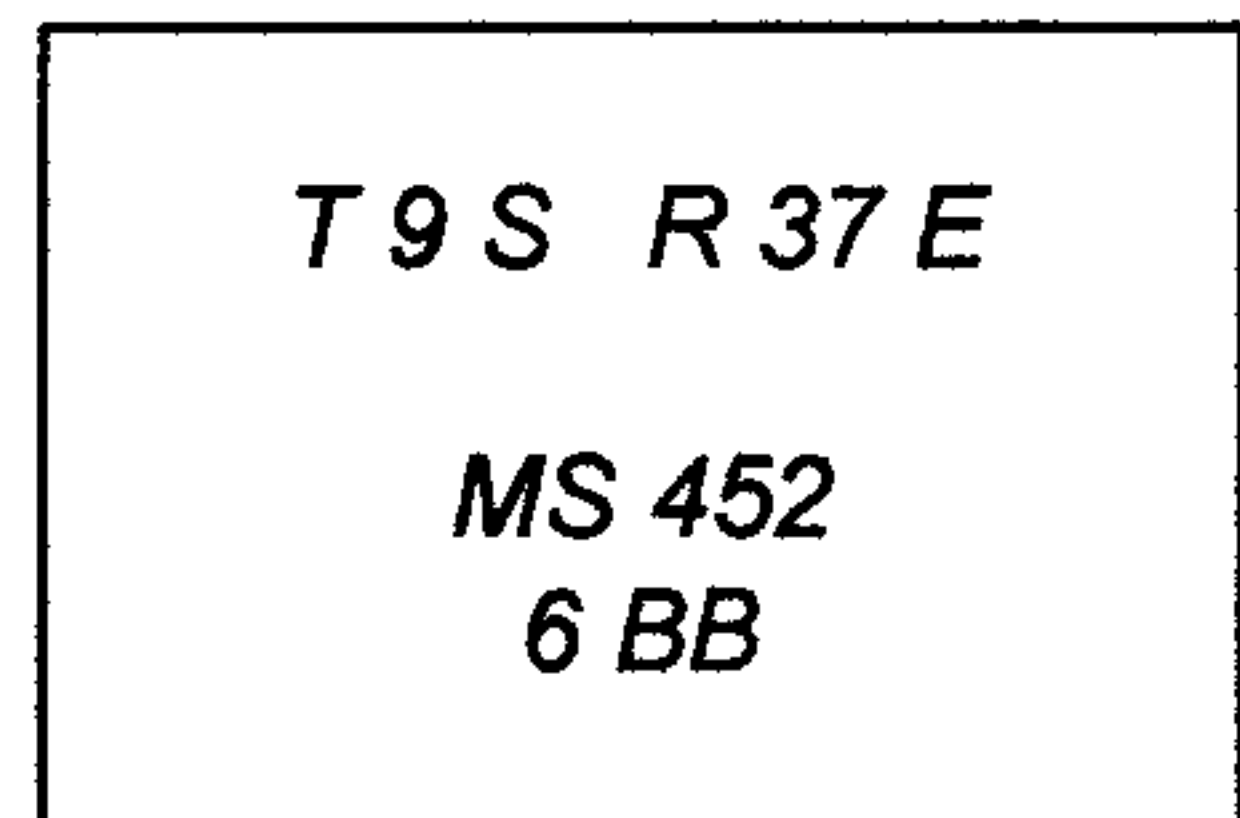

Black Belle
Quartz Claim
Cor. 6

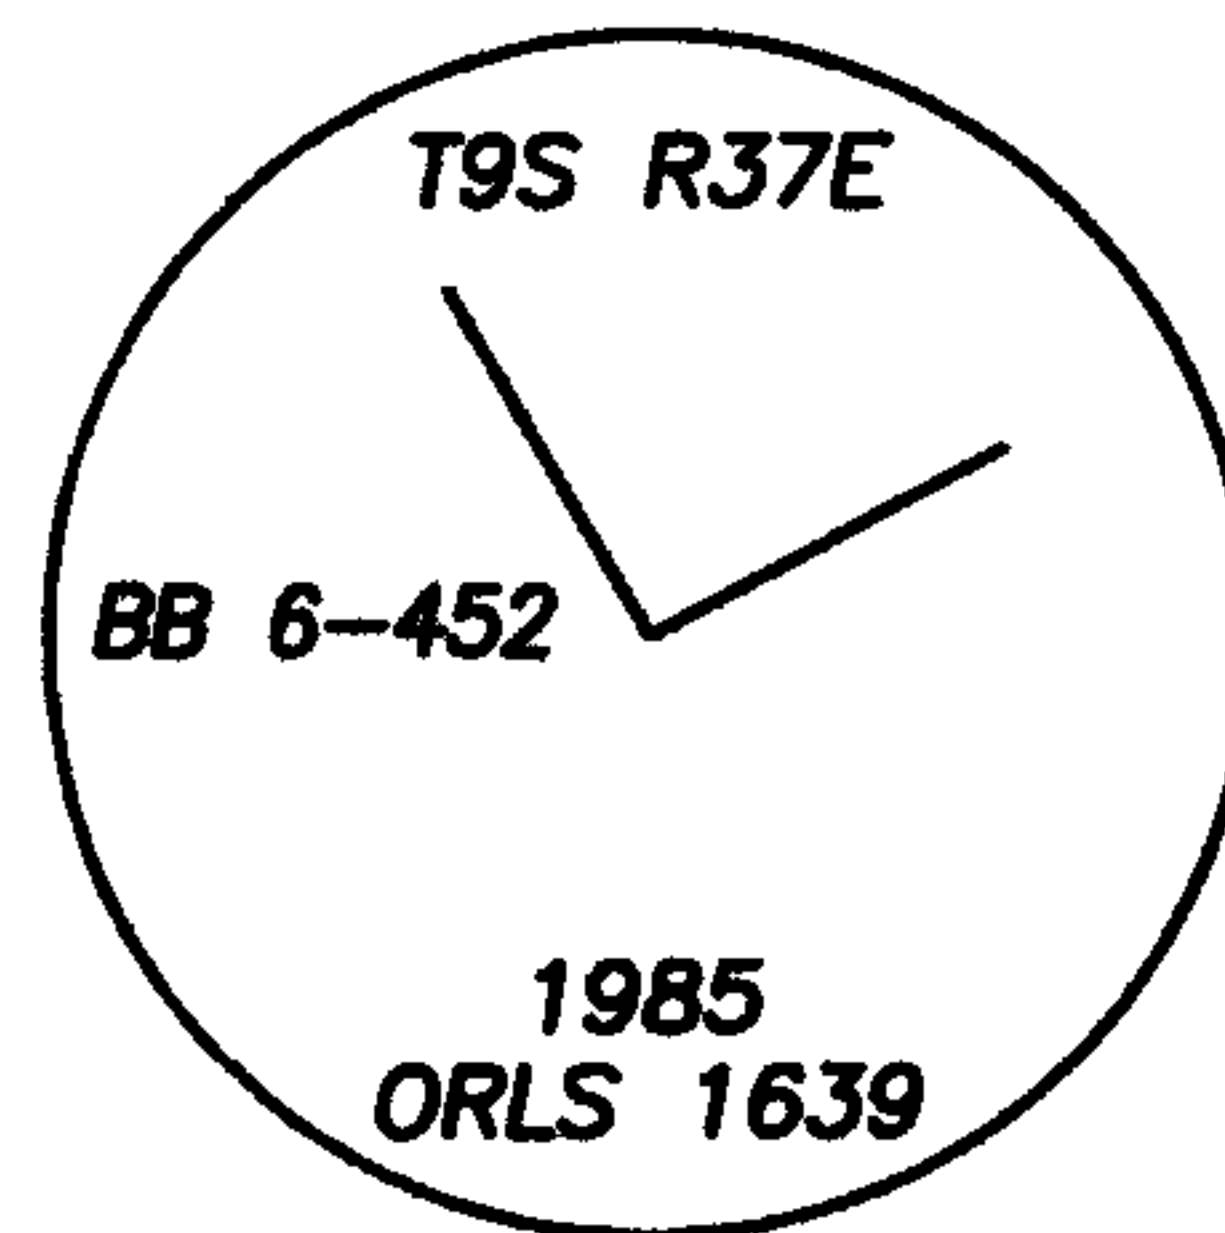

REGISTERED
PROFESSIONAL
LAND SURVEYOR

Kristina Powell

OREGON
MAY 9, 2017
KRISTINA POWELL
91201

EXPIRES 12-31-24

FILED January 3, 2024
BAKER COUNTY SURVEYOR
SURVEY NO. 9-37-364