

CERTIFIED RECORD OF LAND CORNER MONUMENTATION

History of original corner establishment:

Corner originally ESTABLISHED by John Hagel under instructions dated June 30, 1902, for the Amazon Group of quartz claims mineral survey No. 480.

T 9 S R 37 E
MS 480
2 A

Surveyor General records state:

To Cor No 2. Identical with the SW cor of the location. Set a black pine post 5 ins square 4 1/2 ft long 18 ins in the ground scribed AMA.C2-480 with a mound of rocks around it. A tamarack tree 24 ins in diam blazed and scribed AMA.C2-480-BT bears S88°05'W, 8.5 ft.

Amazon
Cor. 2

Corner RECOVERED by: J.R. Mitchell, experienced corner recovery technician, in October, 1970, and he placed sign 54-3 on OBT.

Corner was remonumented by: William L. Hanley, per Corner Record 9-37-151; dated 2-18-88.

No trace of original corner post or rock mound.

A 24" western larch snag with partially healed blaze mkd AMA C 2 480 BT brs S88°05'W, 8.5' dist per record.

At position determined by reversed record bearing and distance from original BT ...

Set 2" x 30" aluminum pipe with a 2 1/2" aluminum cap 25" in ground and surrounded with a mound of earth and stone. Cap marked as shown in corner diagram. Set 6' steel fence post alongside with signs 54-2 and 54-9 attached.

New bearing trees established:

A lodgepole pine 12" dia brs S49°E, 33.6' dist mkd A-2-480 BT.

A lodgepole pine 16" dia brs N60 1/2°E, 51.9' dist mkd A-2-480 BT.

New bearing trees have a brass washer stamped PLS 1639 nailed to face of blaze. Attached signs 54-3 & 54-9 and painted face of blaze and 6" band of red paint around each BT.

Compass declination 20° East.

I hereby certify that the above corner monument was properly REMONUMENTED to U.S.F.S. standards by me and witnessed by Bill Gohring on October 23, 1987.

Continued on page 2 of 2

REGISTERED
PROFESSIONAL
LAND SURVEYOR

Kristina Powell

OREGON
MAY 9, 2017
KRISTINA POWELL
91201

EXPIRES 12-31-24

FILED January 3, 2024
BAKER COUNTY SURVEYOR
SURVEY NO. 9-37-371

CERTIFIED RECORD OF LAND CORNER MONUMENTATION

Description of corner evidence found:

A 2 inch aluminum pipe with a 2 1/2 inch aluminum cap, marked as shown. Firmly set 4 ins. above ground, with rock collar.

From which:

A 24 inch tamarack stump (by Hagel) with open blaze and visible scribing "BT", bears S88°05'W, 8.5 feet.


A 20 inch ponderosa pine (by Hanley) with healed blaze, bears N 60 1/2°E, 51.9 feet, alive and healthy.

A 12 inch pine snag (by Hanley) dead and down, with open blaze and scribing "A 2 480 BT", bears S49°E, 33.6 feet to stump hole.


A steel T-post bears S 28 1/2°, 5.0 feet; with two (2) signs: Property Boundary, Land Survey Monument.

A steel T-post bears N62°E, 35.0 feet; with sign: Property Boundary.

Monument falls North 1,500 feet of the 030 Road.

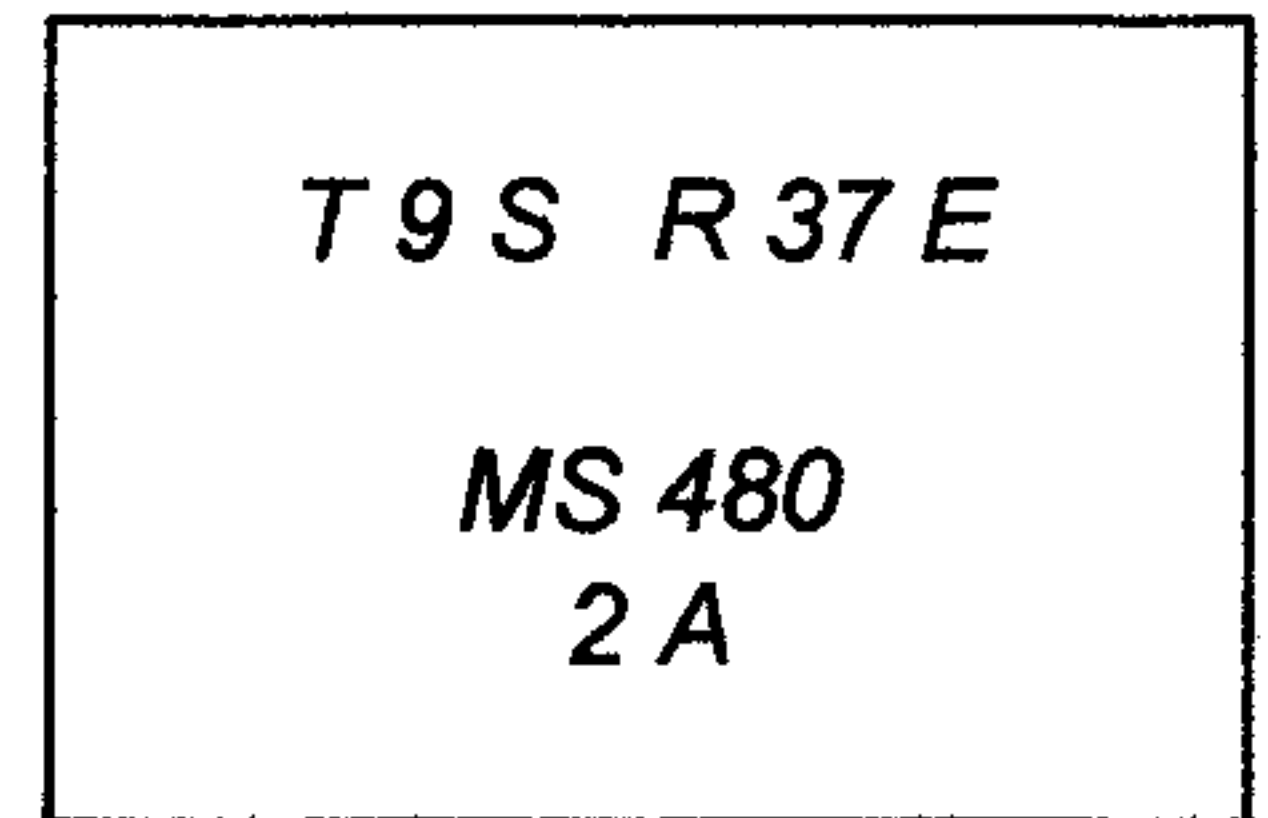

**Amazon
Cor. 2**

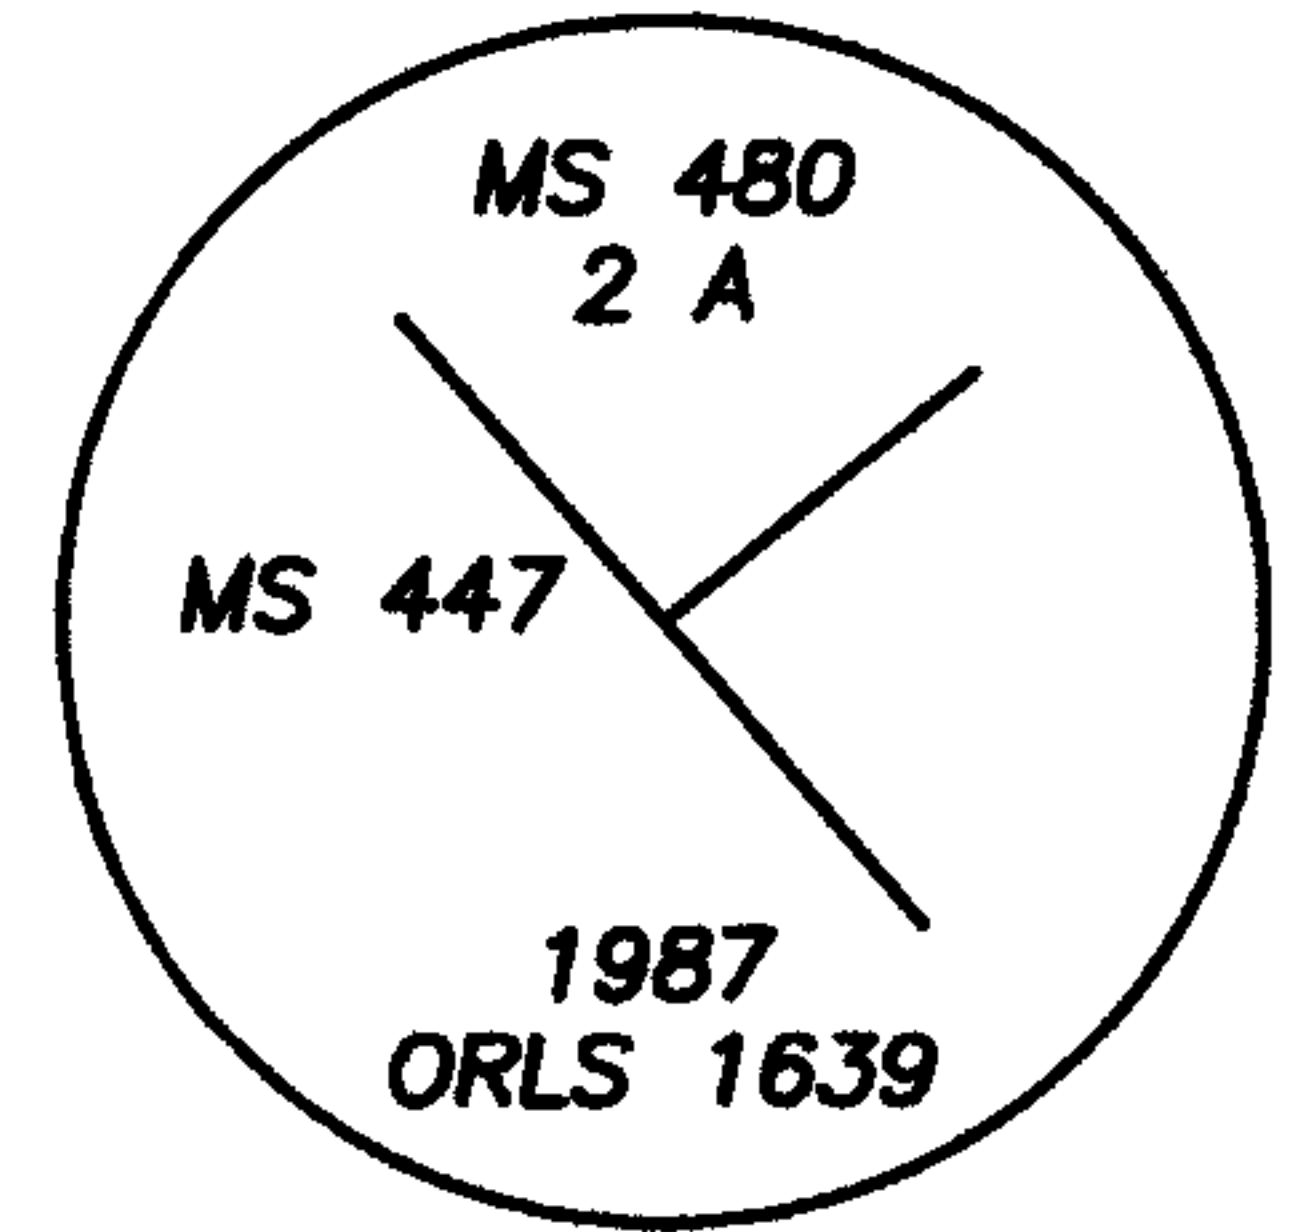

Description of monument and accessories I established to perpetuate original location of this corner:

New Bearing Tree:

A 12 inch tamarack scribed "2A 480 BT" bears N61°W, 45.5 feet; measured to a 3/4 inch brass washer mkd: "LS 91201", at the right side of tree center.

Added Bearing Tree and Land Survey Monument signs as needed.

NAD 83 Geodetic Position

Lat. 44°48'42.4" N
Long. 118°14'00.6 W

Established by: Garmin ETREX 32x

I hereby certify that the corner is monumented and accessories taken as described using a steel tape and a Warren Knight staff compass, set with a declination of 14° East.

Witnesses: David Quittschreiber, Justin Seal

September 12, 2023

REGISTERED
PROFESSIONAL
LAND SURVEYOR

Kristina Powell

OREGON
MAY 9, 2017
KRISTINA POWELL
91201

EXPIRES 12-31-24

FILED January 3, 2024
BAKER COUNTY SURVEYOR
SURVEY NO. 9-37-371