

CERTIFIED RECORD OF LAND CORNER MONUMENTATION

History of original corner establishment:

Corner was originally ESTABLISHED by John Hagel, U.S. Deputy Mineral Surveyor, under instructions dated June 30, 1902, for the Amazon Group of Quartz Claims, Mineral Survey No. 480.

T 9 S R 37 E
MS 480
3-A 3-C

Surveyor General records state:

To Cor No 3 Amazon Lode, identical with the SE cor of the location, identical with Cor No 3 of the Cupid Lode of this survey. Set a black pine post 6 ins square 4 1/2 ft long 18 ins in ground scribed AMA.C.3 S 480 with a mound of earth and rocks around it. A tamarack tree 6 ins diam blazed and scribed AMA.C.3-480-BT bears N76°W, 5.2 ft. A black pine tree 6 ins diam blazed and scribed CUP.C.3-480-BT bears N4°0'W, 10.3 ft.

Amazon
Cor. 3

Cupid
Cor. 3

Corner RECOVERED by: J.R.Mitchell, experienced corner recovery technician, in October, 1970, and he placed sign 54-3 on all OBT's.

Corner was remonumented by: William L. Hanley, per Corner Record 9-37-149; dated 2-18-88.

No trace of original wood post or mound.

OBT: A dead ponderosa pine 8" dia with partially healed blaze brs N0 1/2°W (record, N4°W), 10.3' dist per records mkd CUP.C.3 480 BT.
A dead western larch 8" dia with fully healed blaze brs N80°W (record, N76°W), 5.2' dist per record.

At position determined by record distance & approximate reversed record bearing from original BT's ...

Set 2" x 30" aluminum pipe with a 2 1/2" aluminum cap 25" in ground and surrounded with a mound of earth and stone. Cap marked as shown in corner diagram. Set 6' steel fence post alongside with signs 54-2 and 54-9 attached.

New bearing trees established:

A western larch 9" dia brs N15°E, 12.8' dist mkd C-3-480 BT.
A western larch 14" dia brs N37°W, 44.1' dist mkd A-3-480 BT.

New bearing trees have a brass washer stamped PLS 1639 nailed to face of blaze. Attached signs 54-3 & 54-9 and painted face of blaze and 6" band of red paint around each BT.

Compass declination 20° East.

I hereby certify that the above corner monument was properly REMONUMENTED to U.S.F.S. standards by me and witnessed by Bill Gohring on October 27, 1987.

Continued on page 2 of 2

REGISTERED
PROFESSIONAL
LAND SURVEYOR

Kristina Powell

OREGON
MAY 9, 2017
KRISTINA POWELL
91201

EXPIRES 12-31-24

FILED January 3, 2024
BAKER COUNTY SURVEYOR
SURVEY NO. 9-37-372

CERTIFIED RECORD OF LAND CORNER MONUMENTATION

Description of corner evidence found:

A 2 inch aluminum pipe with a 2 1/2 inch aluminum cap, marked as shown. Firmly set 10 ins. above ground, with 3 ft. diam. by 2 ft. tall stone mound.

From which:

A 14 inch western larch (by Hanley) with healed blaze, bears N37°W, 44.1 feet, alive and healthy.

An 8 inch pine snag (by Hagel) dead and down with visible scribing "CUP C 3 480 BT", bears N1/2°W, 10.3 feet to stump hole.

An 8 inch western larch snag (by Hagel) with healed blaze, bears N80°W, 5.2 feet.

A 9 inch western larch snag (by Hanley) with open blaze and visible scribing "C 3 480 BT"; bears N15°E, 12.8 feet.

A steel T-post bears S62°W, 5.0 feet; with two (2) signs: Property Boundary, Land Survey Monument.

A steel T-post bears N71°E, 15.0 feet; with sign: Property Boundary.

Monument falls West 1,100 feet of the NF-5540 Road

Description of monument and accessories I established to perpetuate original location of this corner:

New Bearing Tree:

A 7 inch spruce scribed "X BT" on single blaze, bears S62°W, 21.6 feet; measured to a 3/4 inch brass washer mkd: "LS 91201", at the right side of tree center.

Added Bearing Tree and Land Survey Monument signs as needed.

NAD 83 Geodetic Position


Lat. 44°48'49.6" N
Long. 118°13'42.1" W

Established by: Garmin ETREX 32x

I hereby certify that the corner is monumented and accessories taken as described using a steel tape and a Warren Knight staff compass, set with a declination of 14° East.


Witnesses: David Quittschreiber, Justin Seal

September 12, 2023

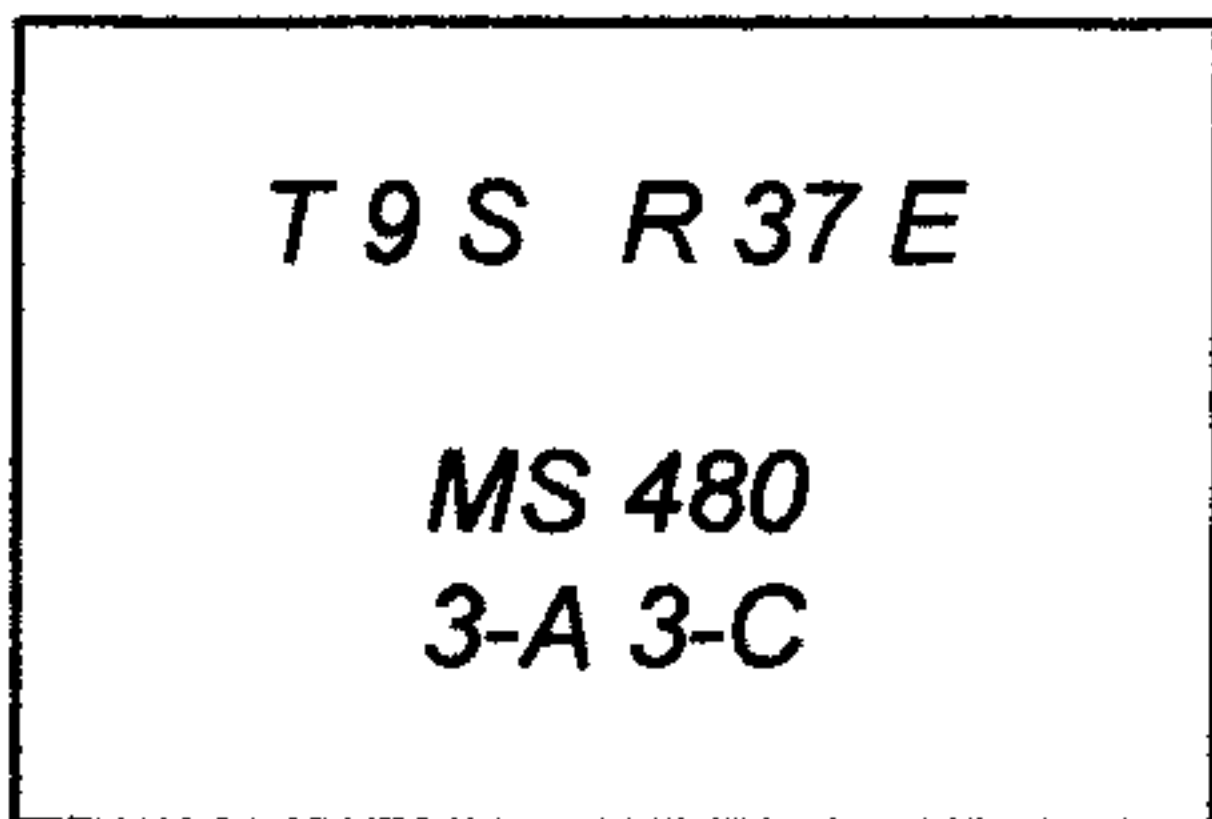

Amazon
Cor. 3

Cupid
Cor. 3

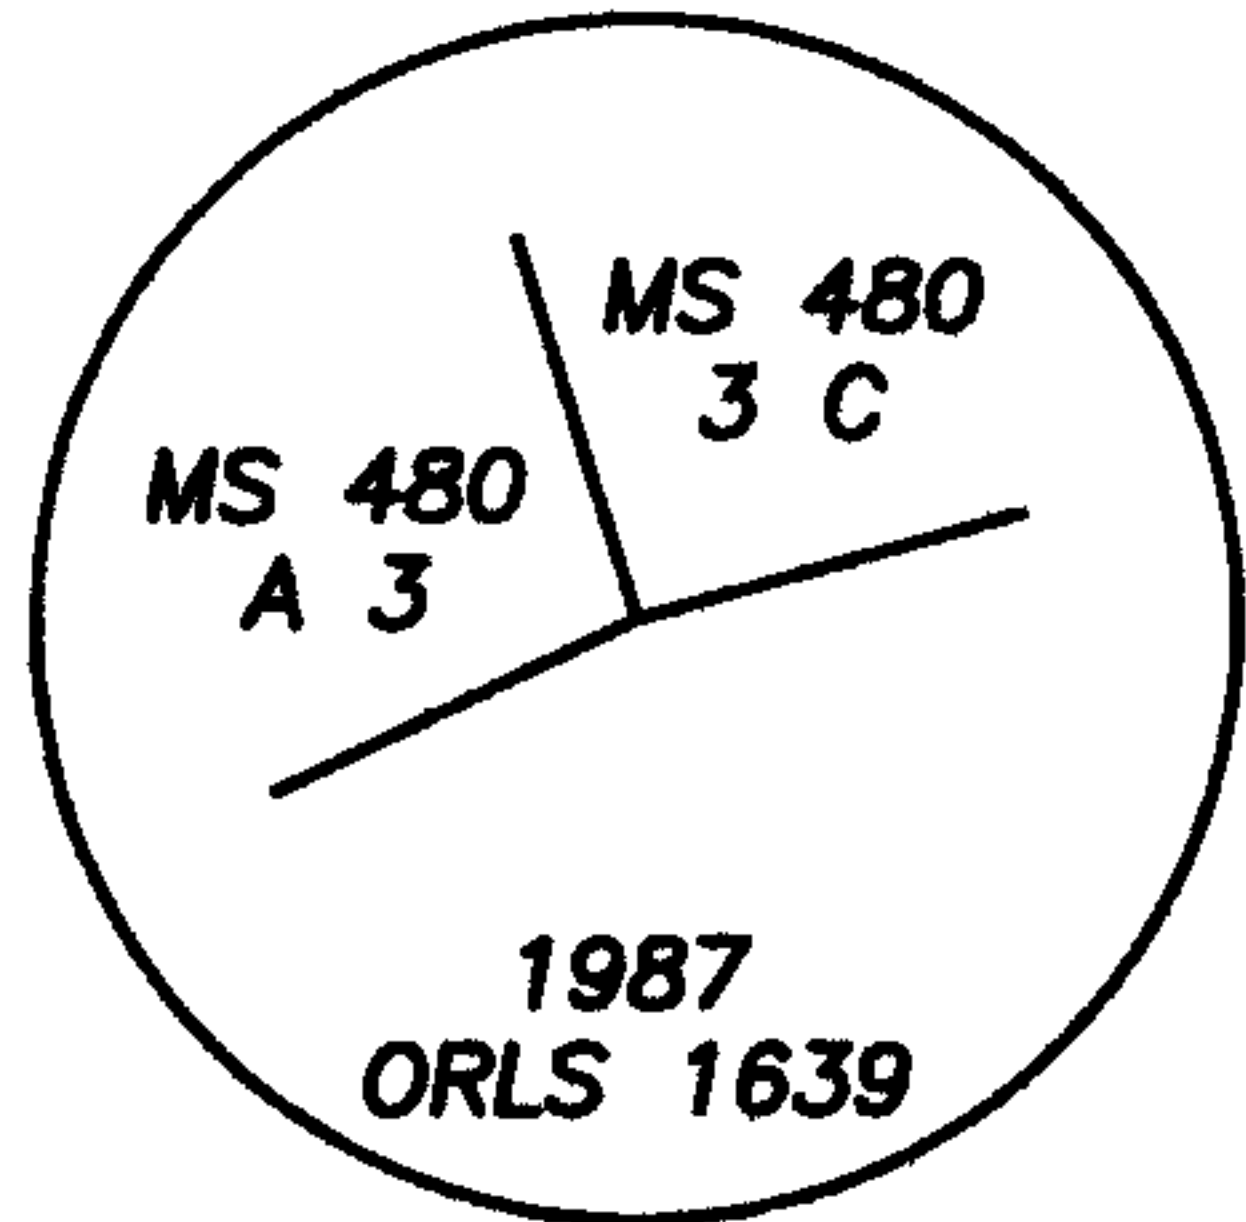

REGISTERED
PROFESSIONAL
LAND SURVEYOR

Kristina Powell

OREGON
MAY 9, 2017
KRISTINA POWELL
91201

EXPIRES 12-31-24

FILED January 3, 2024
BAKER COUNTY SURVEYOR
SURVEY NO. 9-37-372