

**CERTIFIED RECORD OF LAND CORNER MONUMENTATION**

**History of original corner establishment:**

Corner ESTABLISHED by Wm. W. Elmer, U.S. Deputy Mineral Surveyor, under instructions dated November 28, 1905, for the survey of the Orleans Quartz Mining Claim, MS 653 A.

T 9 S R 37 E  
MS 653A  
4 0

Surveyor General records state:

Cor No 4 (Orleans Lode), a pine post 4 ins square, 4 ft long set 1 1/2 ft in ground with mound of earth and stone, scribed 4-653 A. Or., whence a pine 6 ins dia bears S42°15'W, 15.65 ft, a pine 8 ins dia bears S22°26'E, 20.10 ft, both blazed and scribed 4-653 A Or. BT. Cor No 1 Orleans Mill Site bears S47°33'W, 5 ft.

Orleans  
Cor. 4

Corner was remonumented by: William L. Hanley, per Corner Record 9-37-157; dated 2-18-88.

Found a 1 1/2 x 30" steel pipe projecting 3" above the ground in surrounding rock mound, origin unknown, from which:

OBT: A lodgepole pine 13" dia with partially healed blaze mkd 1-653B ORMBT & 4 653A ORBT brs S22°26'E, 20.10' dist per record.

A lodgepole pine 9" dia with partially healed blaze mkd A OR BT & 653 B OR M BT brs S42°15'W, 15.65' dist per record.

Additionally, a lodgepole pine 20" dia with previously opened blaze with face axed over and fragmentary scribe marks remaining brs S65°E, 12.2' (no record of this tree).

At position of 1 1/2 dia steel pipe...

Removed 1 1/2" steel pipe & replace with a 2" x 30" aluminum pipe with 2 1/2" aluminum cap 25" in ground, surrounded with mound of earth & stone. Cap marked as shown in corner diagram. Set 6' steel fence post alongside with signs 54-2 & 54-9 attached. Buried original pipe inside aluminum pipe.

No new bearing trees established.

Painted 6" band of red paint around each original BT, also painted blaze and attached signs 54-3 & 54-9 to all BTs.

Compass declination 20° East.

I hereby certify that the above corner monument was properly REMONUMENTED to U.S.F.S. standards by me and witnessed by Bill Gohring on December 28, 1987.

Continued on page 2 of 2

REGISTERED  
PROFESSIONAL  
LAND SURVEYOR

*Kristina Powell*

OREGON  
MAY 9, 2017  
KRISTINA POWELL  
91201

EXPIRES 12-31-24

FILED January 3, 2024  
BAKER COUNTY SURVEYOR  
SURVEY NO. 9-37-375

**CERTIFIED RECORD OF LAND CORNER MONUMENTATION**

2 of 2

**Description of corner evidence found:**

A 2 inch aluminum pipe with a 2 1/2 inch aluminum cap, marked as shown. Firmly set 4 inches above ground, with a rock collar.


From which:

A 13 inch lodgepole pine (by Elmer) with open blaze and visible scribing, bears S22°26'E, 20.1 feet, alive and healthy.


SW BT (by Elmer) not found.

Bearing Tree, (Origin unknown per Hanley Corner Report):  
A 20 inch lodgepole pine with axe marks and scribing on open blaze, bears S42°15'W, 15.65 feet.

Monument falls West 235 feet from NF-5540 Road; and East 80 feet from a 10-ft wide gravel road.

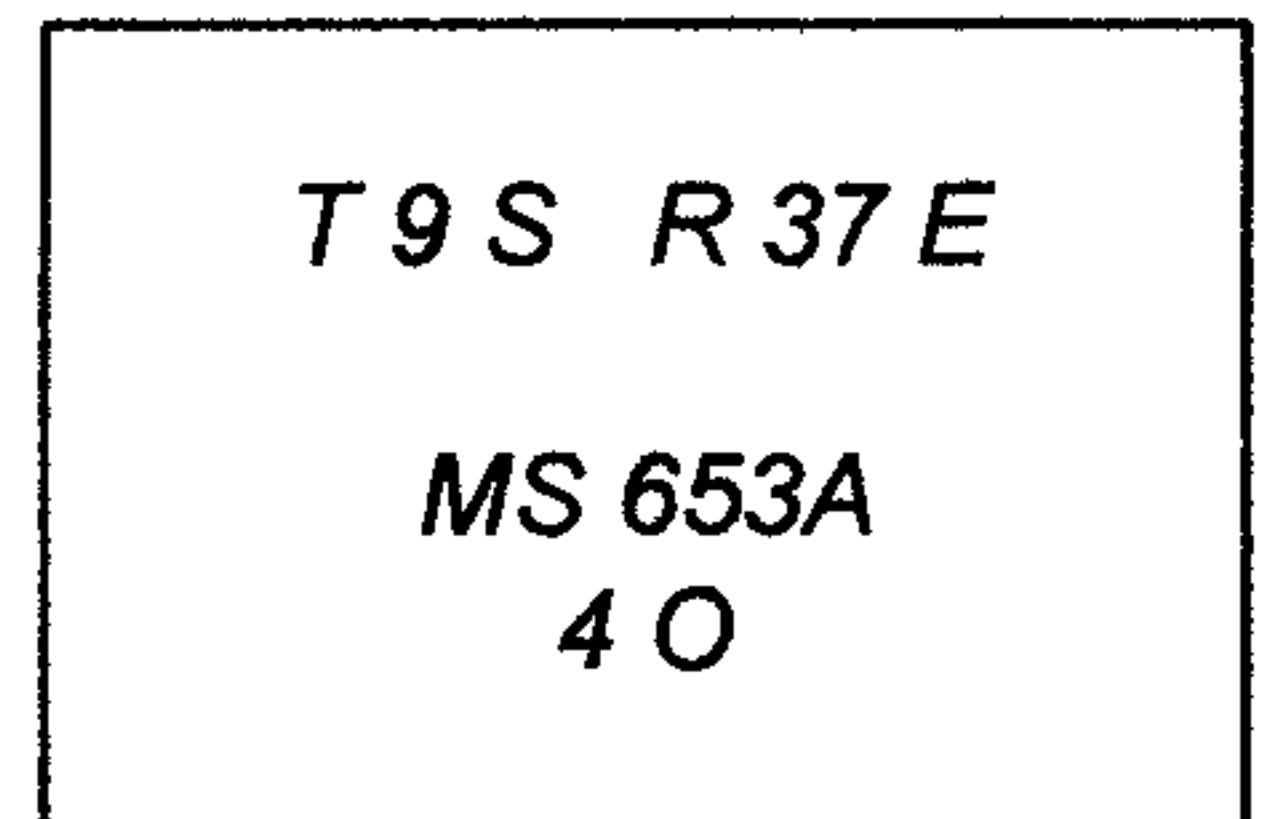

Orleans  
Cor. 4

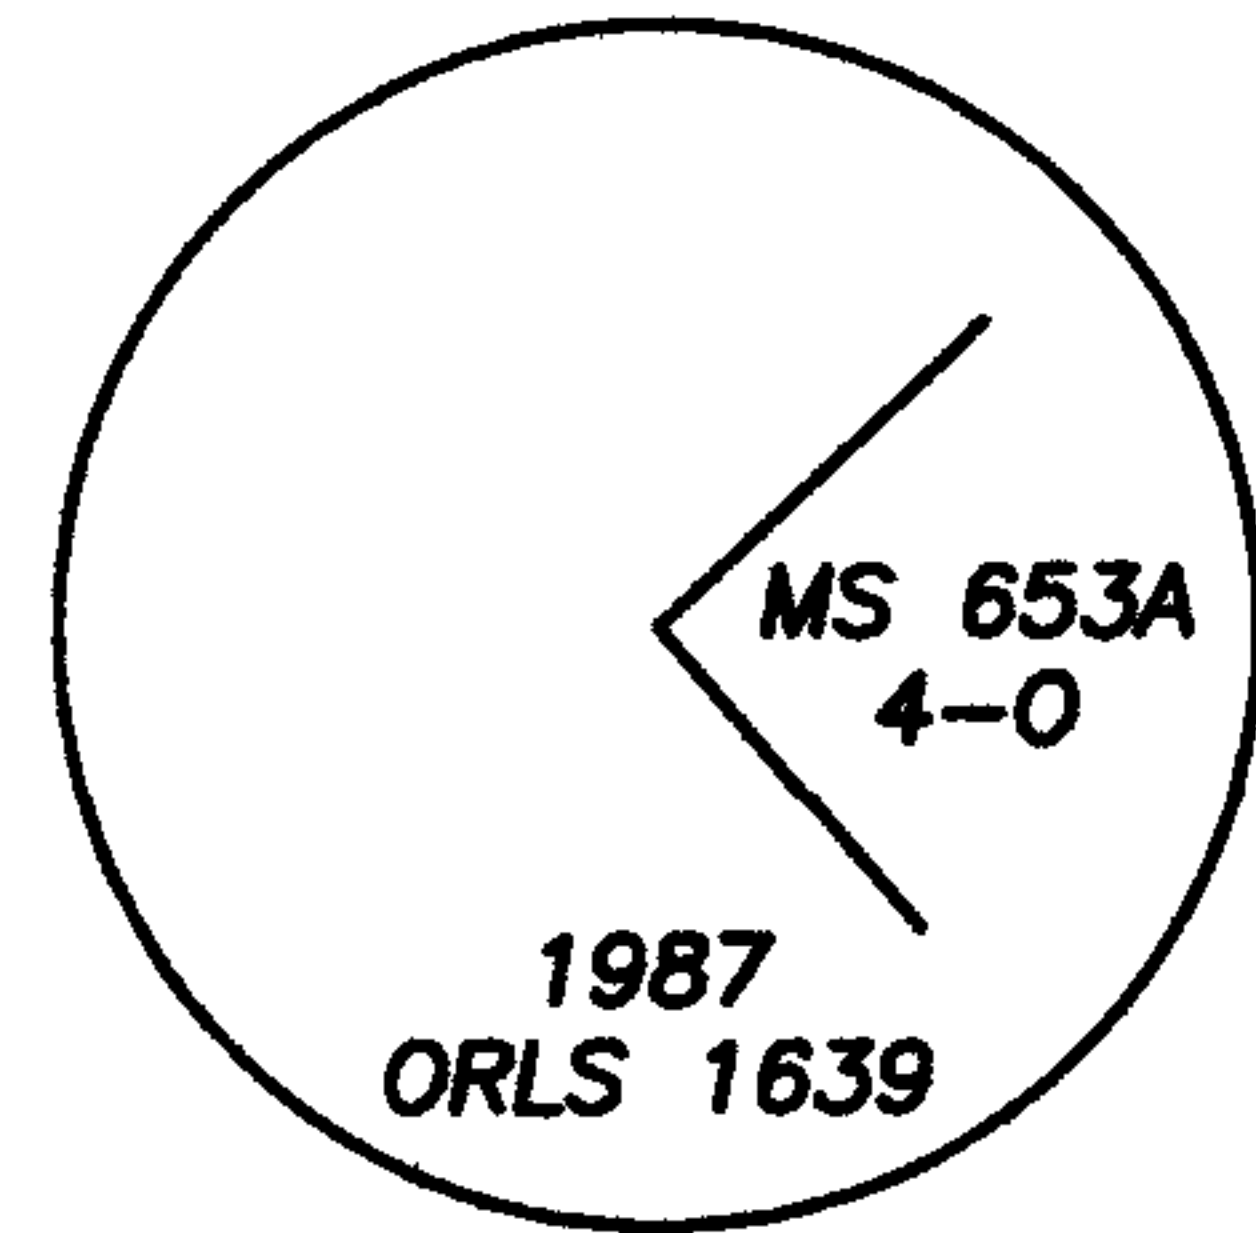

**Description of monument and accessories I established to perpetuate original location of this corner:**

New Bearing Tree:

A 16 inch spruce scribed "4 MS 653A BT" bears N10°W, 76.8 feet; measured to a 3/4 inch brass washer mkd: "LS 91201", at the right side of tree center.

Set a steel T-post N49°E, 3.0 feet; with two (2) signs: Property Boundary, Land Survey Monument

Added Bearing Tree and Land Survey Monument signs as needed.

NAD 83 Geodetic Position

Lat. 44°48'48.7" N  
Long. 118°13'30.6" W

Established by: Garmin ETREX 32x

I hereby certify that the corner is monumented and accessories taken as described using a steel tape and a Warren Knight staff compass, set with a declination of 14° East.

Witnesses: David Quittschreiber, Justin Seal, Shar Hutchison

August 8, 2023

REGISTERED  
PROFESSIONAL  
LAND SURVEYOR

*Handwritten signature*

OREGON  
MAY 9, 2017  
KRISTINA POWELL  
91201

EXPIRES 12-31-24

FILED January 3, 2024  
BAKER COUNTY SURVEYOR  
SURVEY NO. 9-37-375