

CERTIFIED RECORD OF LAND CORNER MONUMENTATION

History of original corner establishment:

Corner ESTABLISHED by Wm. W. Elmer, U.S. Deputy Mineral Surveyor, under instructions dated November 28, 1905, for the Survey of Orleans Millsite, MS 653 B.

T 9 S R 37 E
MS 653 B
1 OMS

Orleans Mill Site
Cor. 1

Surveyor General records state:

Beginning at Cor.No.1, a pine post 4 ins square 4 ft long set 1 1/2 ft in the ground with a mound of earth and stone, scribed 1-653-B.Or.M., whence N.E. location corner, identical with Cor.No.4, Orleans (Orleans) lode this survey, previously described, bears N47°33'E., 5 ft.

Corner was remonumented by: William L. Hanley, per Corner Record 9-37-169; dated 5-2-88.

A 20" lodgepole pine brs S83°E, 14.8' dist from reestablished corner position with previously opened blaze with face axed over & fragment scribe marks remaining (no record).

OBTs: A lodgepole pine 13" diam brs S31°E, 19.5' from reestablished corner position mkd 653BORM BT & 4653AOR BT on a partially healed blaze.

A lodgepole pine 9" diam brs S37°W, 10.4' dist from reestablished corner position mkd 653BORM BT & 653AOR BT on partially healed blaze. (no record of either of these OBTs)

At position determined by survey (see Record of Survey Plat filed separately for method of corner position reestablishment) ...

Set 2" x 30" aluminum pipe with 2 1/2" dia aluminum cap attached 25" in ground surrounded with a mound of earth & stone and placed 6' steel fence post alongside with signs 54-9 & 54-2 attached. Aluminum cap marked as shown to the right.

No new bearing trees established. Used old bearing trees (not of record) as recovered.

Each bearing tree has signs 54-3 & 54-9 attached below a surrounding 6" band of red paint.

Compass declination 20° East.

I hereby certify that the above described corner was REESTABLISHED and MONUMENTED to USFS standards by me and witnessed by Bill Gohring on December 28, 1987.

REGISTERED
PROFESSIONAL
LAND SURVEYOR

Kristina Powell

OREGON
MAY 9, 2017
KRISTINA POWELL
91201

EXPIRES 12-31-24

Continued on page 2 of 2

FILED January 3, 2024
BAKER COUNTY SURVEYOR
SURVEY NO. 9-37-376

CERTIFIED RECORD OF LAND CORNER MONUMENTATION

Description of corner evidence found:

A 2 inch aluminum pipe with a 2 1/2 inch aluminum cap, marked as shown. Firmly set 3 inches above ground, with a rock collar.

From which:

B.T., not of record. A 20 inch lodgepole pine, with axe marks, open blaze and visible scribing, bears S83°E, 14.8 feet, alive.

A 13 inch lodgepole pine (by Elmer) with partially healed blaze and visible scribing bears S31°E, 19.5 feet, alive and healthy.


S.W. B.T. by Elmer not found.

Monument falls West 235 feet from NF-5540 Road; and East 85 feet from a 10-ft wide gravel road.

Monument falls on edge of semi-permanent camping site.

T 9 S R 37 E
MS 653 B
1 OMS

Orleans Mill Site
Cor. 1

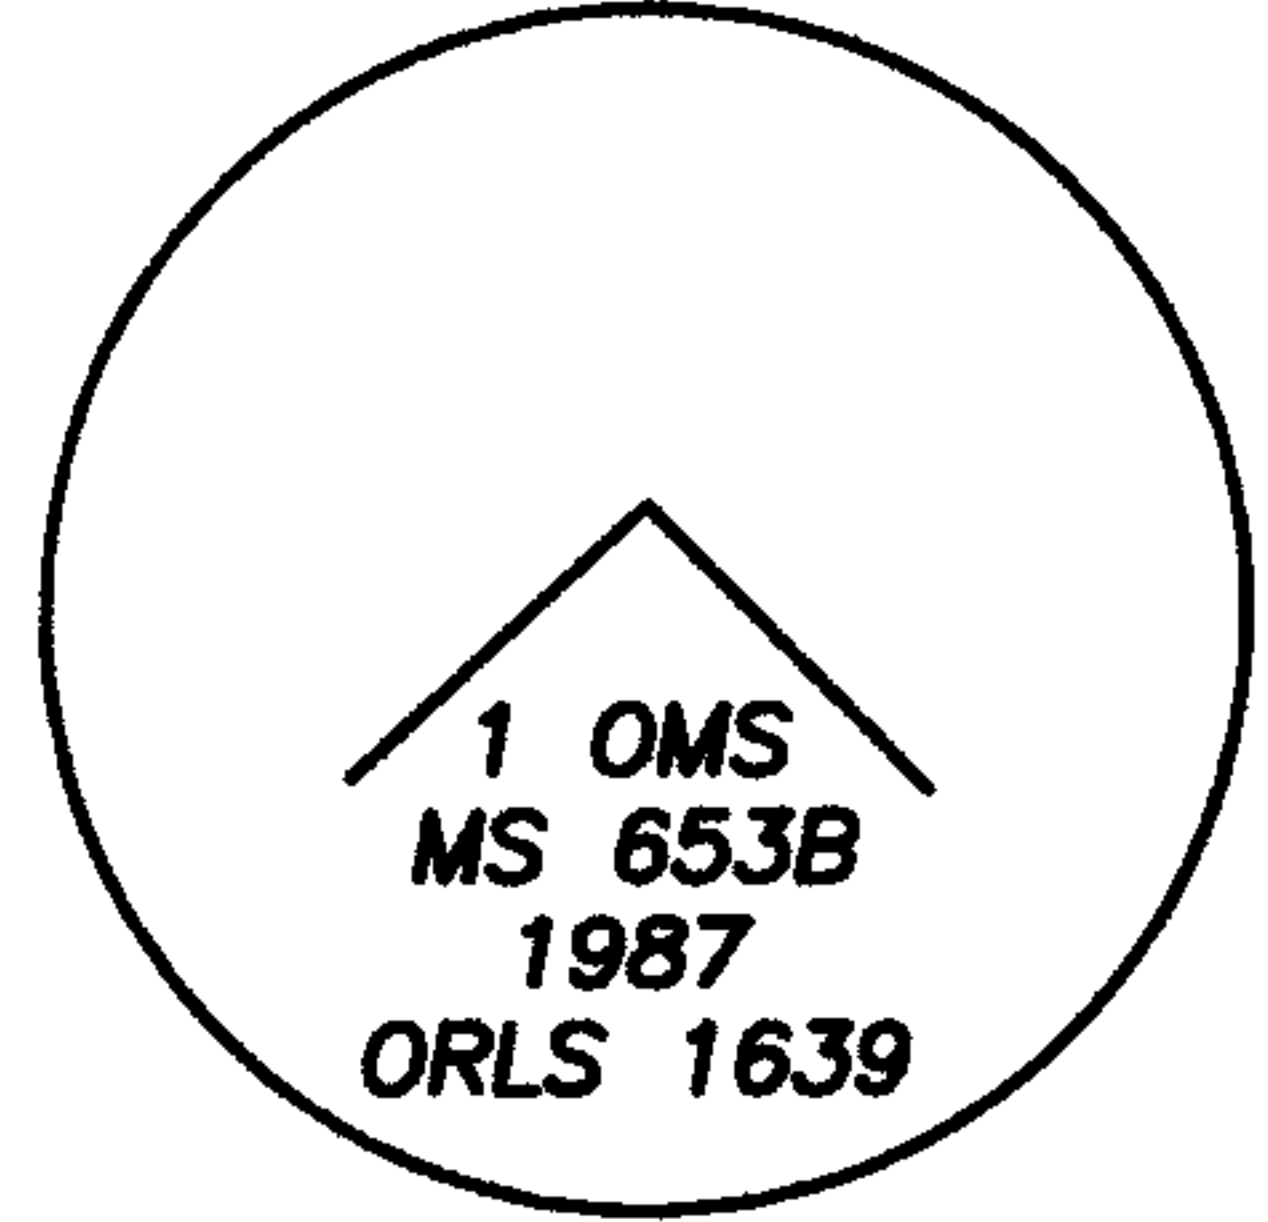

Description of monument and accessories I established to perpetuate original location of this corner:

New bearing Tree:

A 6 inch white fir scribed "1 653B BT" bears S84°W, 78.0 feet; measured to a 3/4 inch brass washer mkd: "LS 91201", at the right side of tree center.

Set a steel T-post S47°W, 2 feet; with two (2) signs: Property Boundary, Land Survey Monument.

Added Bearing Tree and Land Survey Monument signs as needed.

NAD 83 Geodetic Position

Lat. 44°48'49.2" N
Long. 118°13'30.7" W

Established by: Garmin ETREX 32x

I hereby certify that the corner is monumented and accessories taken as described using a steel tape and a Warren Knight staff compass, set with a declination of 14° East.

Witnesses: David Quittschreiber, Justin Seal, Shar Hutchison

August 8, 2023

REGISTERED
PROFESSIONAL
LAND SURVEYOR

K.P. Powell

OREGON
MAY 9, 2017
KRISTINA POWELL
91201

EXPIRES 12-31-24

FILED January 3, 2024
BAKER COUNTY SURVEYOR
SURVEY NO. 9-37-376