

CERTIFIED RECORD OF LAND CORNER MONUMENTATION

History of original corner establishment:

Corner ESTABLISHED by Wm. W. Elmer, U.S. Deputy Mineral Surveyor, under instructions dated November 28, 1905, for the Survey of Orleans Millsite, MS 653 B.

Surveyor General records state:

Cor. No. 2, a pine post 5 ins square 4 ft long set 1 1/2 ft in the ground, with a mound of earth and stone, scribed 2-653-B.Or.M., whence S.E. location Cor. identical with Cor. No. 3, Orleans Lode of this Survey, previously described, bears N.47°33'E., 5 ft.

T 9 S R 37 E  
MS 653 B  
2 OMS  
Orleans Mill Site  
Cor. 2

Corner was remonumented by: William L. Hanley, per Corner Record 9-37-170; dated 5-2-88

Corner post not found – no record of bearing trees.

A lodgpole pine 13" diam mkd 3653AOR BT and 2653BORM BT, on single blaze brs N87°E, 42.6' dist (no record) and it is recorded and tagged as an official BT to the reestablished corner point.

At position determined by survey (see Record of Survey Plat filed separately for method of corner position reestablishment) ...

Set 2" x 30" aluminum pipe with a 2 1/2" dia aluminum cap attached 25" in ground surrounded with a mound of earth & stone and placed 6' steel fence post alongside with signs 54-9 & 54-2 attached. Aluminum cap marked as shown to the right.

New bearing tree established:  
A lodgepole pine 8" diam brs S33°W, 30.3' dist mkd OMS-2-653B BT.

Each bearing tree has signs 54-3 & 54-9 attached below a surrounding 6" band of red paint. New bearing tree has a brass washer marked PLS 1639 nailed flush to red painted blaze.

Compass declination 20° East.

I hereby certify that the above described corner was REESTABLISHED and MONUMENTED to USFS standards by me and witnessed by Bill Gohring on December 28, 1987.

Description of corner evidence found:

A 2 inch aluminum pipe with a 2 1/2 inch aluminum cap, marked as shown. Firmly set 2 inches above ground, with a rock collar.

From which:

B.T.s, by Elmer, not found

A 13 inch lodgepole pine (by Hanley) with a partially healed blaze and visible scribing, bears S33°W, 30.3 feet, alive and healthy.

A steel T-post bears S47 1/2°W, 5 feet; with two (2) signs: Property Boundary, Land Survey Monument

Monument lies 13 feet SW of center of NW – SE aligned, 10-foot wide gravel road.

Description of monument and accessories I established to perpetuate original location of this corner:

New Bearing Tree:

A 7 inch lodgepole pine scribed "X BT" on single blaze, bears S46°E, 19.1 feet; measured to a 3/4 inch brass washer mkd: "LS 91201", at the right side of tree center.

Added Bearing Tree and Land Survey Monument signs as needed.

NAD 83 Geodetic Position

Lat. 44°48'44.2" N  
Long. 118°13'26.1" W


Established by: Garmin ETREX 32x

I hereby certify that the corner is monumented and accessories taken as described using a steel tape and a Warren Knight staff compass, set with a declination of 14° East.

Witnesses: David Quittschreiber, Justin Seal, Shar Hutchison

August 8, 2023

Form R6-7100-57 (9/71)

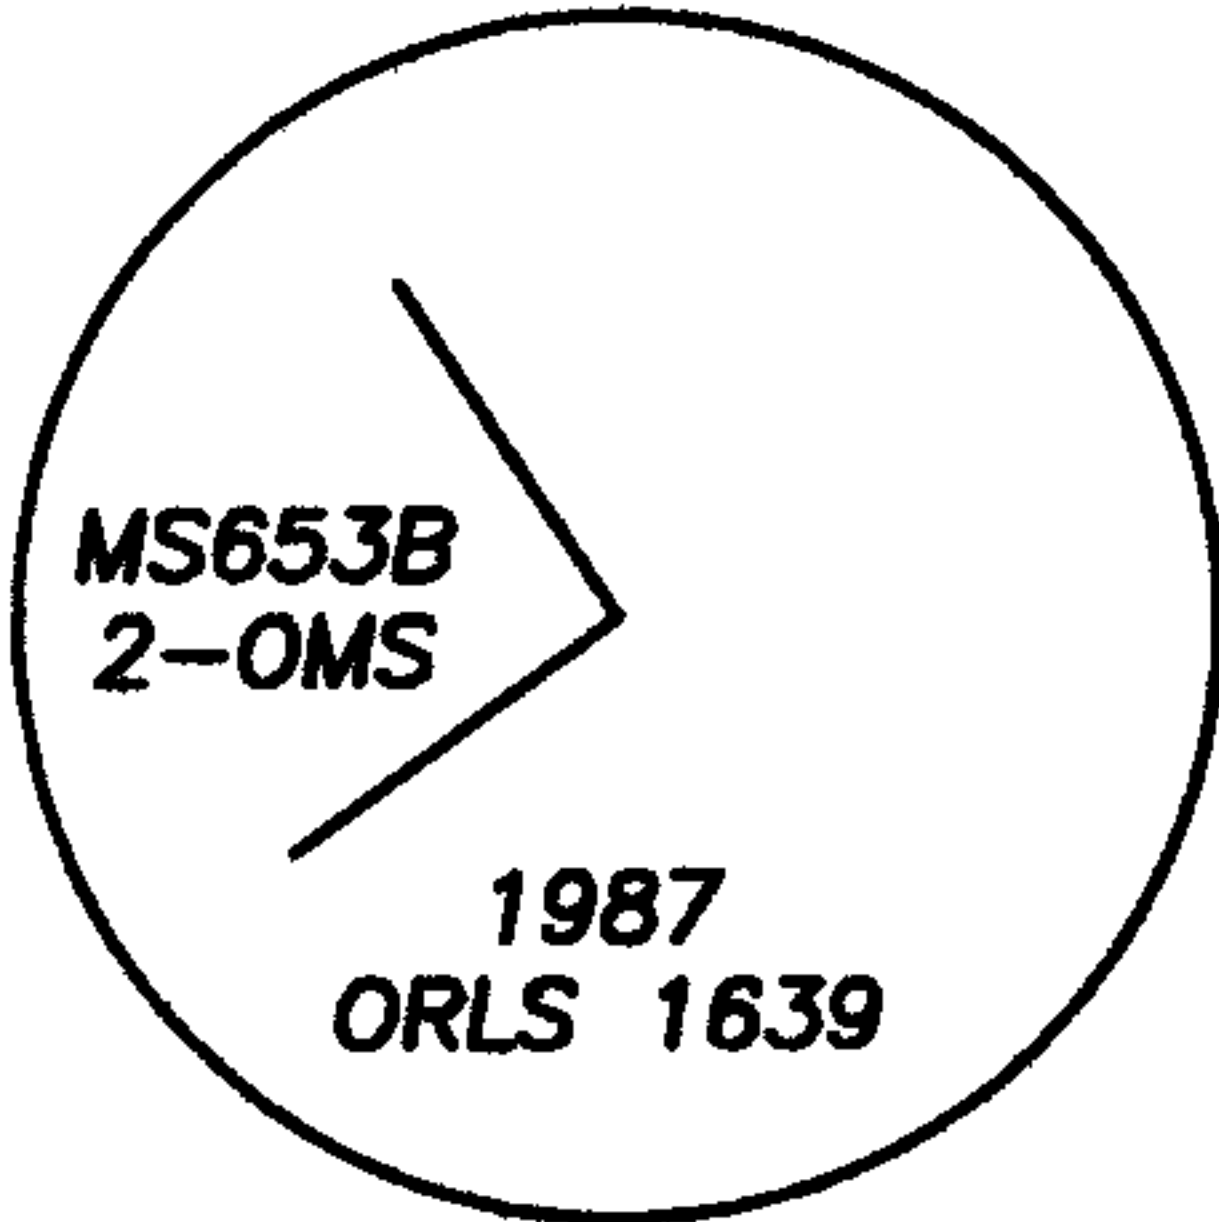

REGISTERED  
PROFESSIONAL  
LAND SURVEYOR

Justin Seal

OREGON  
MAY 9, 2017  
KRISTINA POWELL  
91201

EXPIRES 12-31-24

FILED January 3, 2024  
BAKER COUNTY SURVEYOR  
SURVEY NO. 9-37-377