

CERTIFIED RECORD OF LAND CORNER MONUMENTATION

History of original corner establishment:

Corner ESTABLISHED BY Wm. W. Elmer, U.S. Deputy Mineral Surveyor, under instructions dated November 28, 1905, for the survey of Orleans Millsite, MS 653 B.

T 9 S R 37 E
MS 653B
4 OMS

Surveyor General records state:

Cor No 4 (Orleans Millsite), identical with NW Cor of the location, a pine post 4 ins square, 4 ft long set 1 1/2 ft in the ground with mound of earth and stone, scribed 4-653-B Or.M., whence a pine 4 ins dia bears S45°07'E, 4.80 ft, a pine 6 ins dia bears N78°06'E, 28.14 ft, both blazed and scribed 4-653-B Or M BT.

Orleans Mill Site
Cor. 4

Corner was remonumented by: William L. Hanley, per Corner Record 9-37-159; dated 2-18-88.

Found a 3" x 3" x 36" wood post laying on ground scribed Cor 4 B on one side and Cor 5 A on the other side with surrounding rock mound and rotten wood remains of post to depth of 18".

OBT: A dead lodgepole pine 9" dia brs S45°07'E, 4.8' dist as per record with opened blaze scribed Or M BT.

A lodgepole pine 12" dia brs N78°06'E, 28.1' dist as per record with partially healed blaze scribed 4 653B Or M.

At position of wood post with surrounding rock mound ...

Set a 2" x 30" aluminum pipe with 2 1/2" aluminum cap 25" in ground and surrounded with a mound of earth and stone. Cap marked as shown in corner diagram. Set 6' steel fence post alongside with signs 54-2 and 54-9 attached. Laid wood post alongside.

New bearing tree established:

A western larch 9" dia brs S20°W, 8.8' dist mkd OMS-4-653B BT.

New bearing trees have a brass washer stamped PLS 1639 nailed to face of blaze. Attached signs 54-3 & 54-9 and painted face of blaze and 6" band of red paint around each BT.

Compass declination 20° East.

I hereby certify that the above corner monument was properly REMONUMENTED to U.S.F.S. standards by me and witnessed by Bill Gohring on November 11, 1987.

Continued on page 2 of 2

REGISTERED
PROFESSIONAL
LAND SURVEYOR

Kristina Powell

OREGON
MAY 9, 2017
KRISTINA POWELL
91201

EXPIRES 12-31-24

FILED January 3, 2024
BAKER COUNTY SURVEYOR
SURVEY NO. 9-37-379

CERTIFIED RECORD OF LAND CORNER MONUMENTATION

2 of 2

Description of corner evidence found:

A 2 inch aluminum pipe with a 2 1/2 inch aluminum cap, marked as shown. Firmly set 6 inches above ground, with a rock collar.


From which:

B.T.s, by Elmer, not found


A 16 inch western larch (by Hanley) with healed blaze, bears S20°W, 8.8 feet, alive and healthy.

A steel T-post bears N47°E, 5 feet; with sign: Land Survey Monument

Monument falls West 450 feet from the NF-5540 Road; and West 135 feet from a 10-foot wide gravel road.

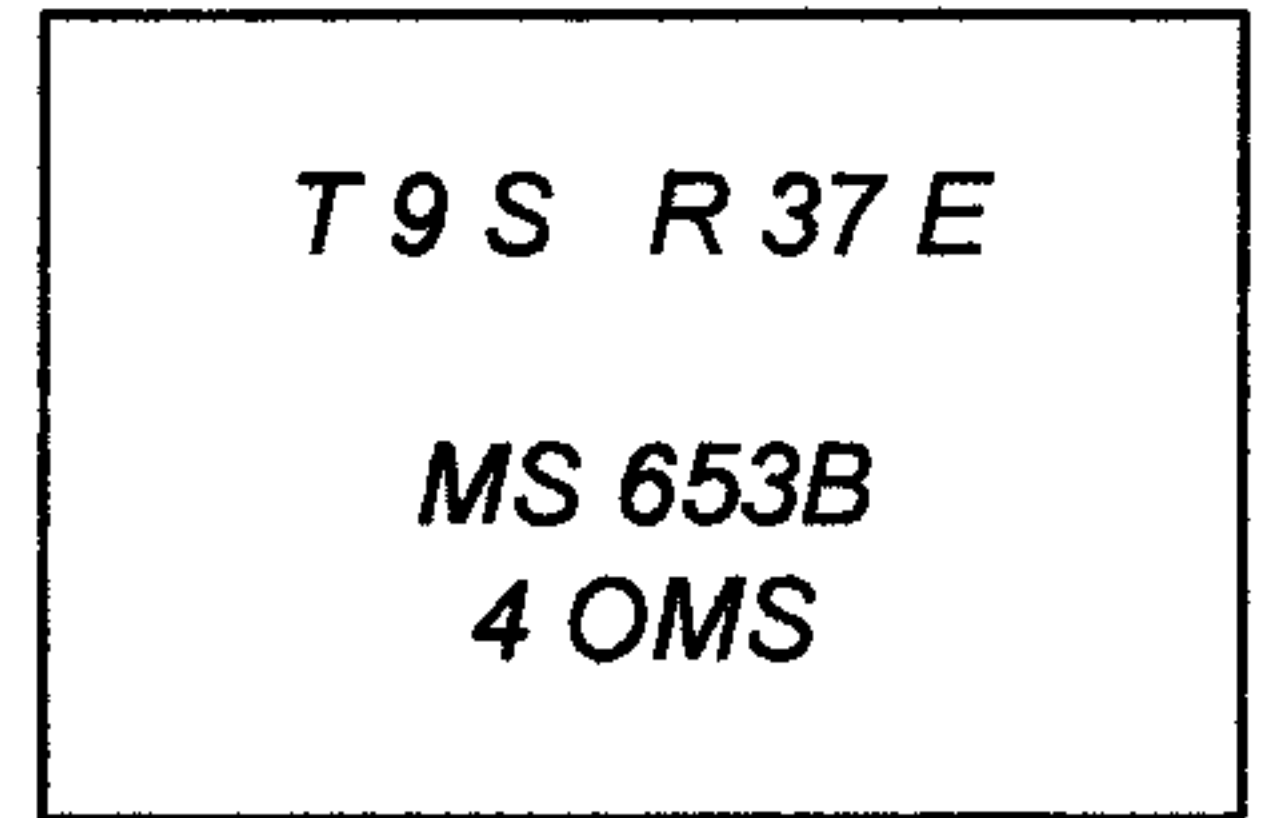

Orleans Mill Site
Cor. 4

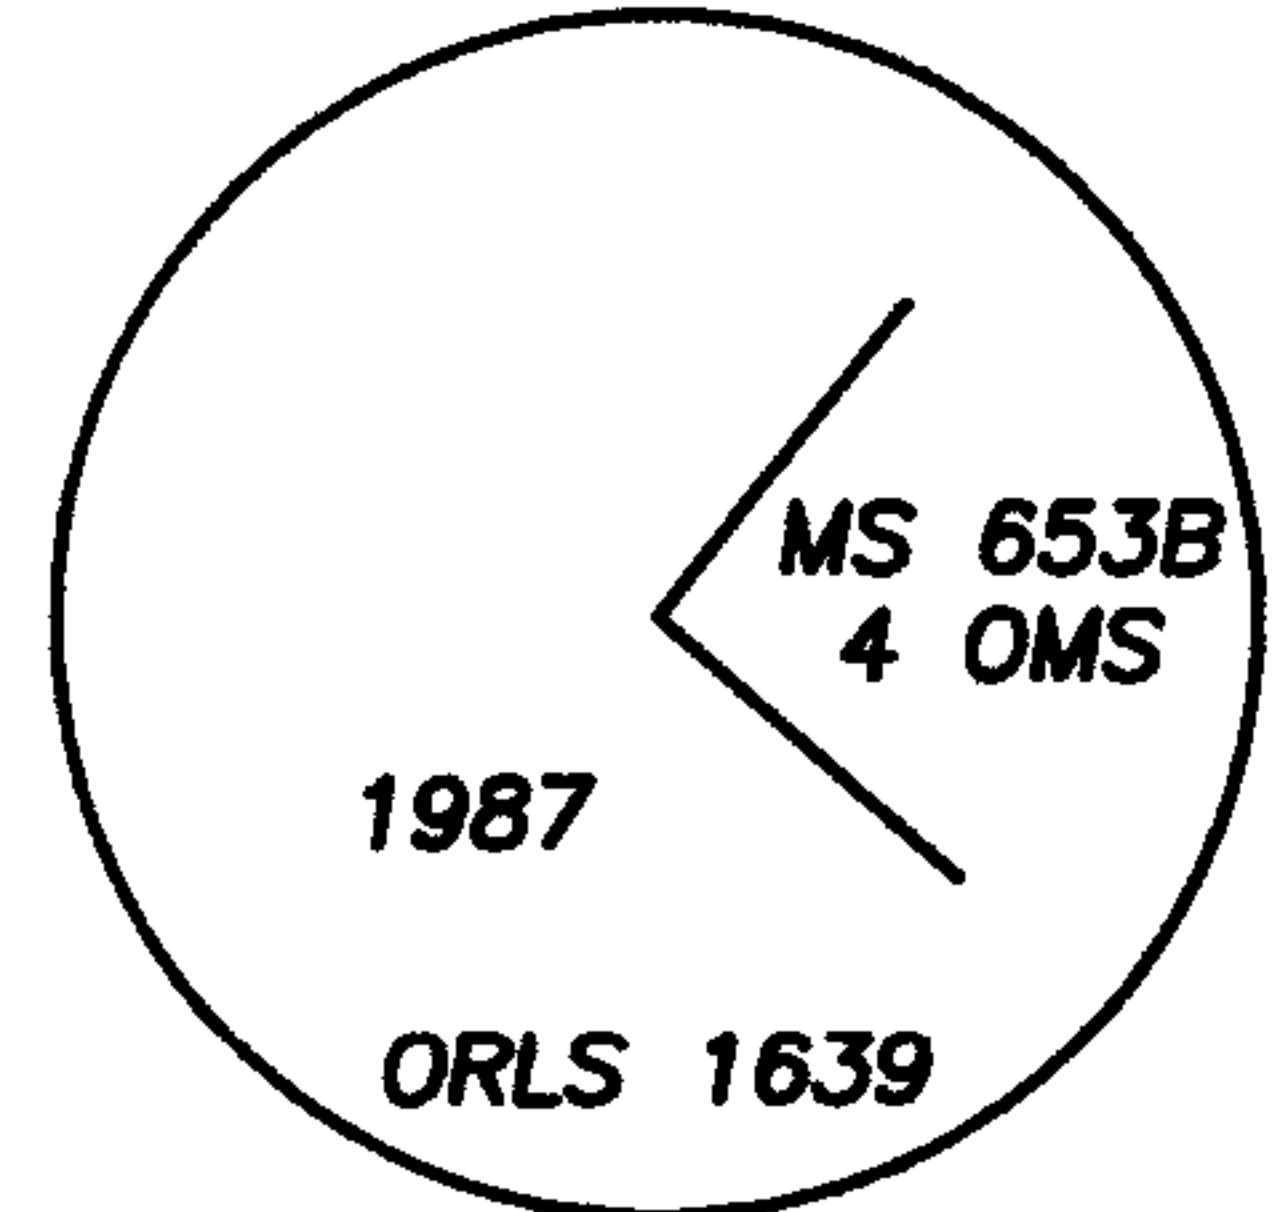

Description of monument and accessories I established to perpetuate original location of this corner:

New Bearing Tree:

A 13 inch lodgepole pine scribed "4 653B BT" bears N60°W, 19.1 feet; measured to a 3/4 inch brass washer mkd: "LS 91201", at the right side of tree center.

Set a steel T-post S37°E, 5 feet; with sign: Property Boundary.

"Property Boundary" sign was added to existing NE guard post.

Added Bearing Tree and Land Survey Monument signs as needed.

NAD 83 Geodetic Position

Lat. 44°48'48.0" N
Long. 118°13'32.1" W

Established by: Garmin ETREX 32x

I hereby certify that the corner is monumented and accessories taken as described using a steel tape and a Warren Knight staff compass, set with a declination of 14° East.

Witnesses: David Quittschreiber, Justin Seal, Shar Hutchison

August 8, 2023

REGISTERED
PROFESSIONAL
LAND SURVEYOR

Kristina Powell

OREGON
MAY 9, 2017
KRISTINA POWELL
91201

EXPIRES 12-31-24

FILED January 3, 2024
BAKER COUNTY SURVEYOR
SURVEY NO. 9-37-379