

CERTIFIED RECORD OF LAND CORNER MONUMENTATION

History of original corner establishment:

Corner ESTABLISHED by Ira L. Hoffman, U.S. Deputy Mineral Surveyor, under instructions dated July 12, 1911, for the survey of Sliver Dick and Blue Swan Quartz Mining Claims, MS 745.

Surveyor General records state:

To Cor. No. 4. A fir post 4 1/2 ft long 5 ins square, set 2 ft in the ground with a mound of earth, scribed B.S.-4-745.

Corner was remonumented by: William L. Hanley, per Corner Record 9-37-174; dated 5-2-88.

No original corner post.

A spruce 20" dia brs S37°E, 77.5' dist from reestablished corner point mkd BT on previously opened blaze (no record).

A sawed western larch stump 35" dia brs S54°W, 105.5' dist from reestablished corner point mkd with fragment of possible "T" scribe inside 5" overgrowth removed this date. (no record)

At position determined by survey (see Record of Survey Plat filed separately for method of corner position reestablishment) ...

Set 2" x 30" aluminum pipe with 2 1/2" dia aluminum cap attached 25" in ground surrounded with a mound of earth & stone and placed 6' steel fence post alongside with signs 54-9 & 54-2 attached. Aluminum cap marked as shown to the right.

New bearing trees established:

A western larch 11" diam brs N47°W, 53.0' dist mkd BS-4-745 BT.

A lodgepole pine 8" diam brs S58 1/2°W, 11.0' dist mkd BS-4-745 BT.

Each new bearing tree has signs 54-3 & 54-9 attached below a surrounding 6" band of red paint and has a brass washer marked PLS 1639 nailed flush to red painted blaze.

Compass declination 20° East.

I hereby certify that the above described corner was REESTABLISHED and MONUMENTED to USFS standards by me and witnessed by Bill Gohring on December 23, 1987.

T 9 S R 37 E
MS 745
4 BS

Blue Swan
Cor. 4

Continued on page 2 of 2

REGISTERED
PROFESSIONAL
LAND SURVEYOR

Kristina Powell

OREGON
MAY 9, 2017
KRISTINA POWELL
91201

EXPIRES 12-31-24

FILED January 3, 2024
BAKER COUNTY SURVEYOR
SURVEY NO. 9-37-394

CERTIFIED RECORD OF LAND CORNER MONUMENTATION

Description of corner evidence found:

A 2 inch aluminum pipe with 2 1/2 inch aluminum cap, marked as shown. Firmly set 7 inches above ground, with rock collar.

From which:

A 9 inch lodgepole pine snag (by Hanley) down and dead, with visible scribing "BS 4 745 BT", bears S 58 1/2°W, 11.0 feet to stump hole. A 3/4 inch brass washer marked "PLS 1639" is affixed to face.


A 19 inch western larch (by Hanley) with healed blaze, bears N47°W, 53.0 feet, alive and healthy.

A 35 inch cut tamarack stump (no record) with axe marks bears S54°W, 105.5 feet.


A steel T-post bears N 47° W, 1 foot; with two (2) signs: Property Boundary, Land Survey Monument.

A steel T-post bears S 31° E, +/- 20 feet; with sign: Property Boundary.

Monument falls South 35 feet from the 030 Road.

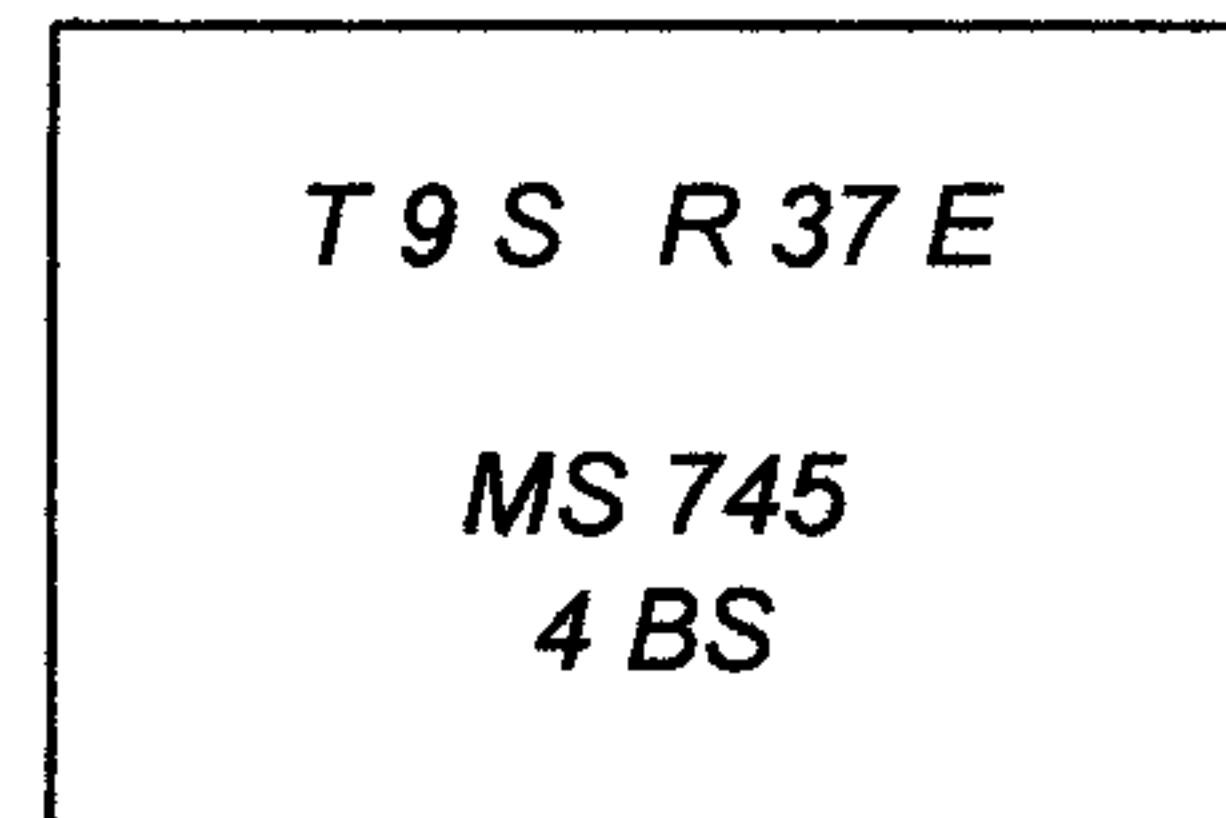

Blue Swan
Cor. 4

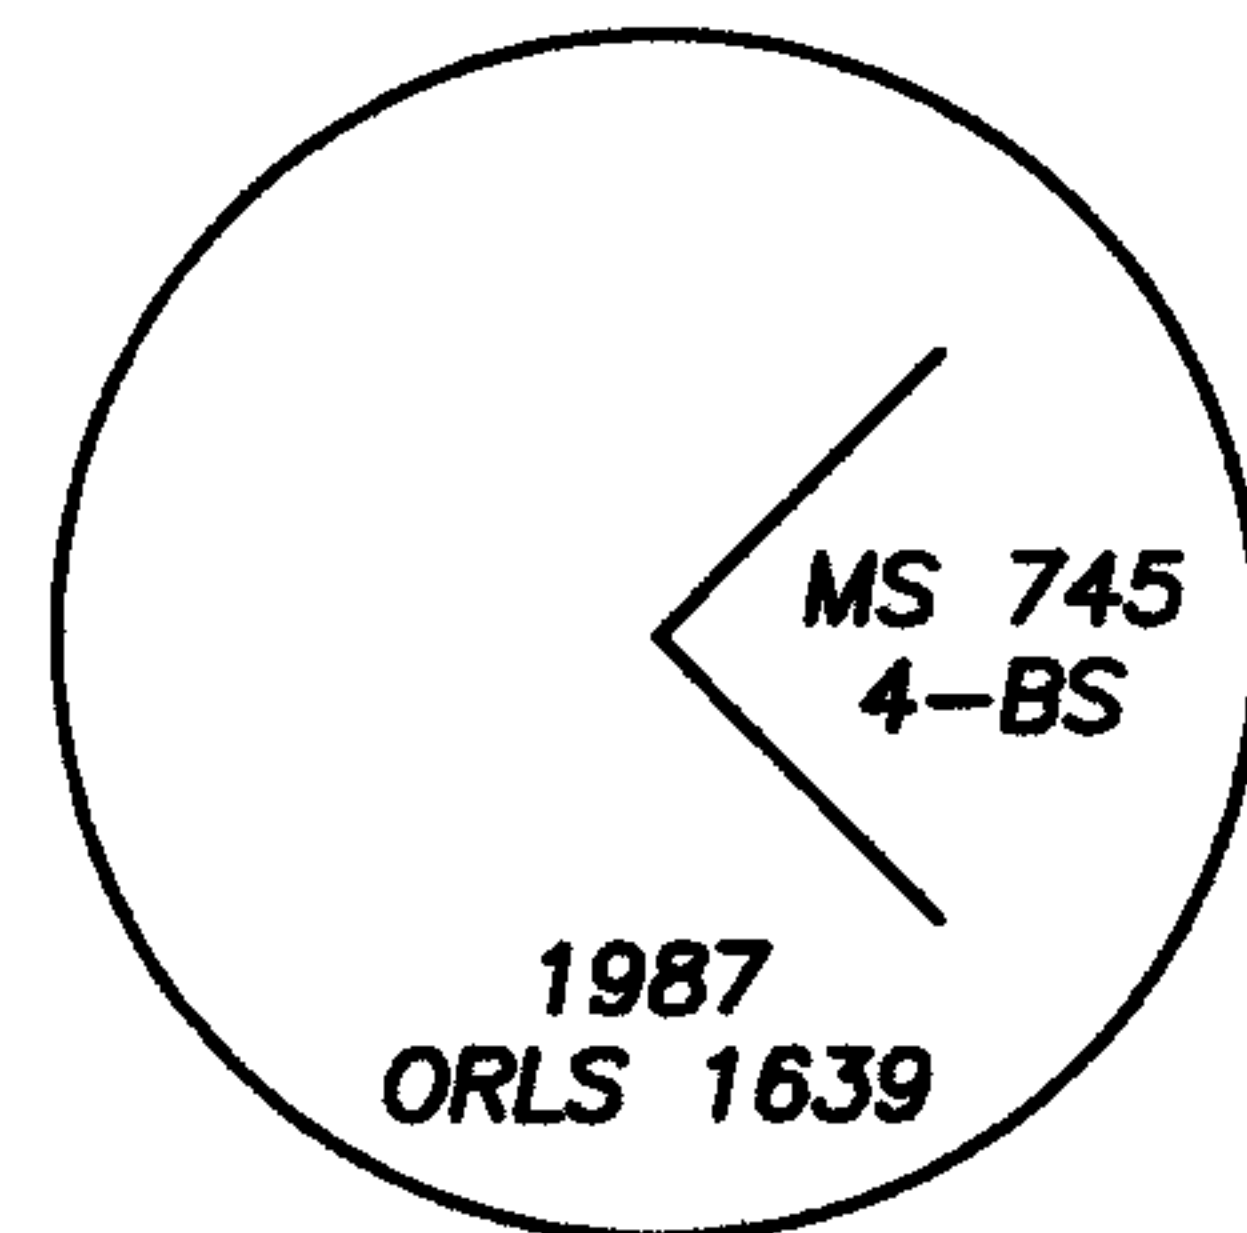

Description of monument and accessories I established to perpetuate original location of this corner:

New Bearing Tree:

A 9 inch tamarack scribed "4 BS 745 BT" bears S 1° W, 20.7 feet; measured to a 3/4 inch brass washer mkd: "LS 91201", at the right-side of tree center.

Added Bearing Tree and Land Survey Monument signs as needed.

NAD 83 Geodetic Position

Lat. 44°48'38.9" N
Long. 118°13'31.0" W

Established by: Garmin ETREX 32x

I hereby certify that the corner is monumented and accessories taken as described using a steel tape and a Warren Knight staff compass, set with a declination of 14° East.

Witnesses: David Quittschreiber, Justin Seal, Shar Hutchison

August 2, 2023

REGISTERED
PROFESSIONAL
LAND SURVEYOR

Kristina Powell

OREGON
MAY 9, 2017
KRISTINA POWELL
91201

EXPIRES 12-31-24

FILED January 3, 2024
BAKER COUNTY SURVEYOR
SURVEY NO. 9-37-394