

CERTIFIED RECORD OF LAND CORNER MONUMENTATION

History of original corner establishment:

Corner established by John Hagel, U.S. Deputy Mineral Surveyor, under instructions received from the United States Surveyor General for Oregon dated Oct. 19, 1899, and designated as Survey No. 378.

T 9 S R 37 E
MS 378
1C / 2 CH

Surveyor General records state:

To Cor. No. 2, a post, previously described, identical with the SW location Cor. identical with Cor. No. 1 Century Lode.

CHARLESTON
Cor. 2

A white fir tree, 9 ins. in diam., bears N77°20'E, 25.4 ft.
A white fir tree, 6 ins. in diam., bears N54°30'E, 23.2 ft.
Both blazed and marked Charl. C. 2-378 BT.

CENTURY
Cor. 1

Corner was remonumented by: John R. Mitchell, an unlicensed Forester, as described by USFS Corner Card, dated 6/1/81.

Record states:

Rotted post in md of earth & stone.

20" WF brs S58°E, 17.6' w/HB.
18" DF brs S77°E, 25.4' w/HB.
18" WF brs S56°E 17' w/HB.

Set a 2 1/2" BC on 1" x 32" gal pipe, set 28" deep in original hole & md of stone, marked CH C2 MS 378 JRM 1981.

11" WF brs S47 1/2°W, 37' & marked CH2 MS378 BT.

Corner was remonumented by: William L. Hanley, as described by Baker County Corner Report No. 8-37-117, filed 2-18-88.

Record states:

Found a JRM 2 1/2" brass cap on 1" galvanized iron pipe with surrounding rock mound, brass cap marked as shown to the right, from which:

OBT: A white fir 26" dia. with fully healed blaze brs S58°E, 17.6' dist per record.
A white fir 17" dia. with fully healed blaze brs S81°E, 17.0' dist (record, S86°E, 17.0' dist)
A douglas fir 17" dia with fully healed blaze brs N79°E (record, N77°20'E), 25.4' dist per record.
A sawed fir stump 18" dia brs N54°30'E, 23.2' dist per record.

JRM BT: A white fir 11" dia with partially healed blaze brs S49 1/2°W, 37.0' dist mkd CH 2 MS 378 BT.

At position of JRM brass cap monument...

Removed brass cap monument & replaces with a 2" x 30" aluminum pipe with 2 1/2" aluminum cap 25" in ground, surrounded with mound of earth & stone. Cap marked as shown in corner diagram. Set 6' steel fence post alongside with sign 54-9 & 54-2 attached.

No new bearing trees established.

Painted 6" band of red paint around each OBT & JRM BT, also painted blaze red, attached signs 54-3 & 54-9 to all BTs.

Compass declination 20° East.

I hereby certify that the above corner monument was properly remonumented to USFS standards by me and witnessed by Bill Gohring on November 9, 1987.

REGISTERED
PROFESSIONAL
LAND SURVEYOR

Kristina Powell

OREGON
MAY 9, 2017
KRISTINA POWELL
91201

EXPIRES 12-31-24

Continued on page 2 of 2

FILED January 8, 2024
BAKER COUNTY SURVEYOR
SURVEY NO. 9-31-396

CERTIFIED RECORD OF LAND CORNER MONUMENTATION

Description of corner evidence found:

A 2 inch aluminum pipe with a 2 1/2 inch aluminum cap, marked as shown. Firmly set 2 inches above ground, with rock collar.

From which:

A 26 inch fir snag (by Hagel) dead and down, with healed blaze, bears S58°E, 17.6 feet to stump hole.

A 22 inch white fir (by Hagel) with healed blaze, bears S81°E, 17.0 feet, alive & healthy.

A 17 inch fir snag (by Hagel) dead and down, with healed blaze, bears N79°E, 25.4 feet to stump hole.

A rotten fir stump (by Hagel), bears N54 1/2°E, 23.2 feet.

A 16 inch white fir (by Mitchell) with healed blaze, bears S49 1/2°W, 37.0 feet, alive & healthy.


A steel T-post falls South 3 feet with Land Survey Monument sign.

Monument falls West 1,500 feet from Fruit Creek Road; approximately 2,700 feet northerly of the intersection with NF-5540 Road.

T 9 S R 37 E
MS 378
1C/2CH

CHARLESTON
Cor. 2

CENTURY
Cor. 1

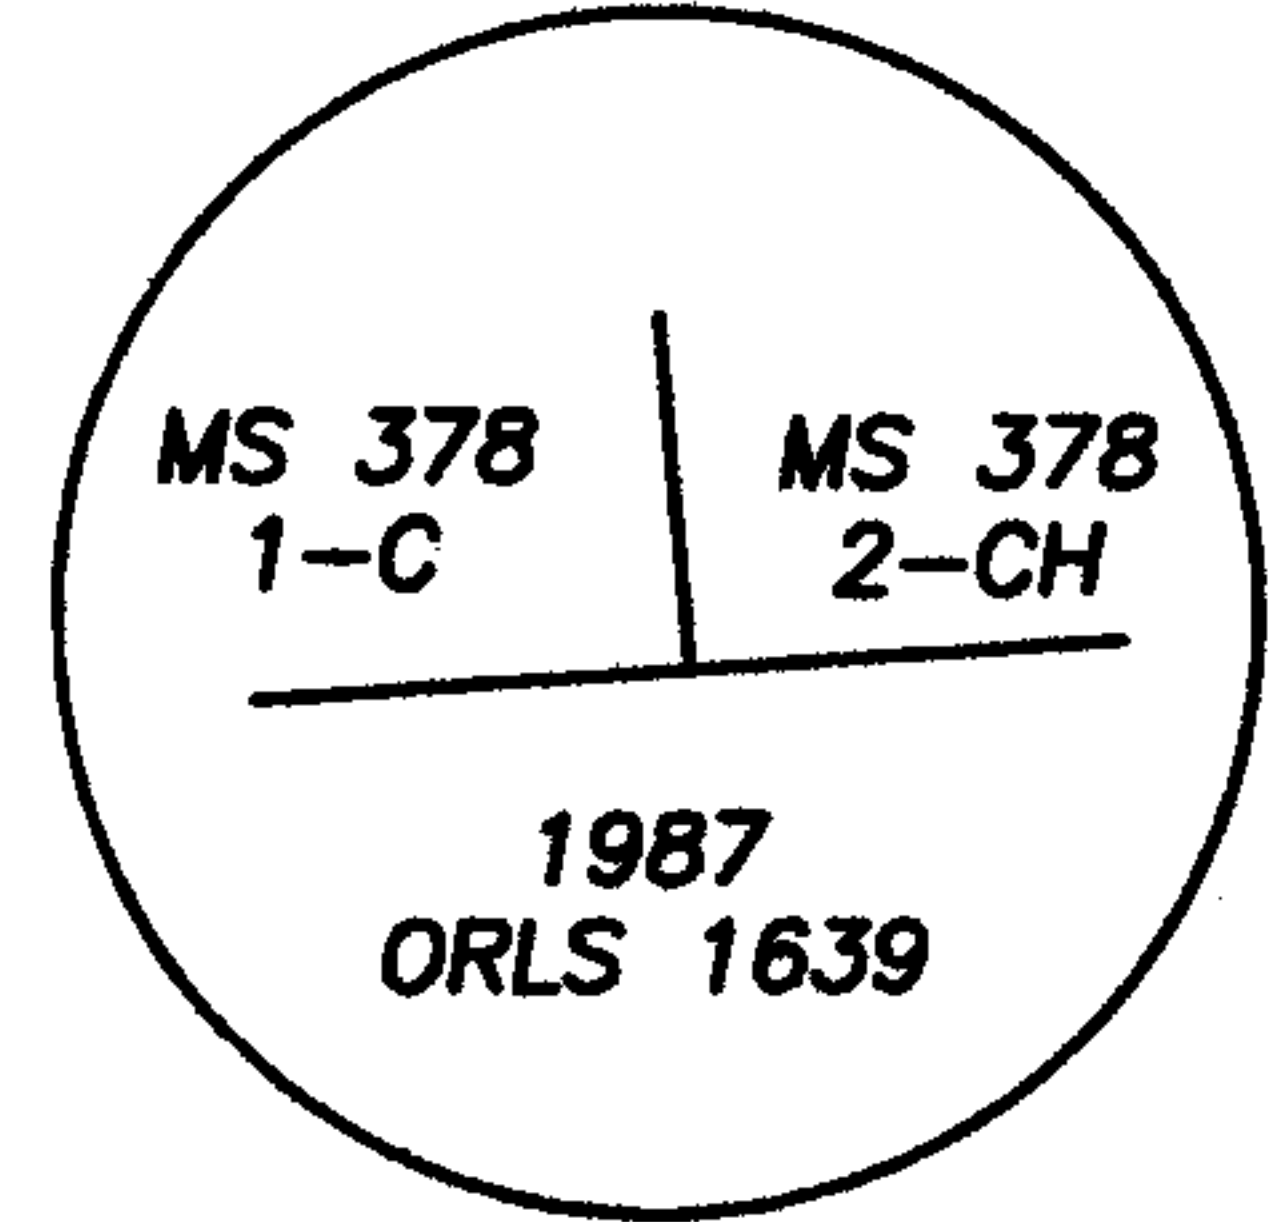

Description of monument and accessories I established to perpetuate original location of this corner:

Added Bearing Tree and Land Survey Monument signs as needed.

NAD 83 Geodetic Position

Lat. 44°49'00.9" N
Long. 118°12'56.3" W

Established by: Garmin ETREX 32x

I hereby certify that the corner is monumented and accessories taken as described using a steel tape and a Warren Knight staff compass, set with a declination of 14° East.

Witnesses: David Quittschreiber, Justin Seal

September 21, 2023

REGISTERED
PROFESSIONAL
LAND SURVEYOR

Kristina Powell

OREGON
MAY 9, 2017
KRISTINA POWELL
91201

EXPIRES 12-31-24

FILED January 8, 2024
BAKER COUNTY SURVEYOR
SURVEY NO. 9-31-396